

Name *WATER*

Service No. *2737*

Address

Location *59 Vine Street*

Kind of Pipe

Size

Size of Main

Repair—Renewal—New Service

Location

Date	Material	Amount	Total	Date	Amount
	Labor				

Hadley Press, Inc., Lexington

DATE _____

TOWN OF LEXINGTON—BOARD OF PUBLIC WORKS

WATER DIVISION

The undersigned applies for a supply of water at No. _____ St. and hereby agrees to comply with the rules and regulations as now, or at any future time, established by the Board of Selectmen.

Am't. of Estimate \$ _____


Owner W. McDevitt.

Am't. Paid \$ _____

Address 59. Vine St.

Builder _____

Sketch of Service Here

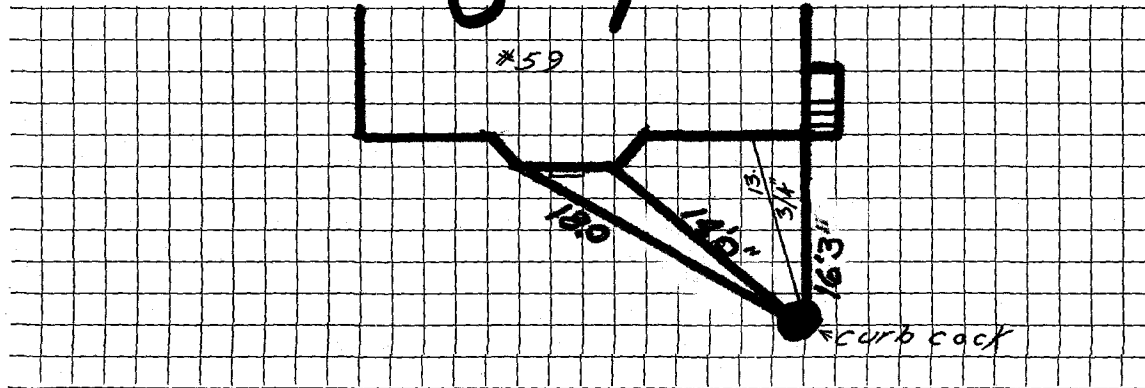

Connection made in _____ Street. Work completed _____ 19

Remarks: