

Name Charles McLaughlin

Service No. 254

Address 81 Vine Street

#6996

Lexington

Locatio

Kind of Pipe

Size

Size of Main

Repair/Replacement - New Service

Com. 12-3-51

Location

Date	Material	Amount	Total	Date	Amount
10/27/51	Labor	1 65	1 65	10-19-51	10 00
	10% overhead		17	12-29-51	1 57
	1 -3/4" C x 1/2 I.W.H. Stop & W.	4 00	4 00		NON CHARGE
	1 hr. trucking		75	10/27/51	Labor 3 60
	patching 5 x 3	5 00	5 00	20' - 3/4" copper tubing @ .326	6 52
			11 57	1 -3/4" C. corp-cock	4 33
	Trench dug by owner			1 -3/4" C x 3/4" C. curb-cock	4 67
	pipe supplied and laid by owner			1 box and rod	4 68
				1 -1/2 straight tail piece	50
				1 -1/2 offset tail piece	50
				1 -hr. trucking	75
				2 hrs. Littlefield shovel @ 7.00	14 00
	Labor				39 55

bill sent 12-3-51

Hadley Press, Inc., Lexington

DATE _____

TOWN OF LEXINGTON—BOARD OF PUBLIC WORKS

WATER DIVISION

The undersigned applies for a supply of water at No. _____ St. and hereby agrees to comply with the rules and regulations as now, or at any future time, established by the Board of Selectmen.

Am't. of Estimate \$ _____


Owner _____

Am't. Paid \$ _____

Address _____

Builder _____

Sketch of Service Here

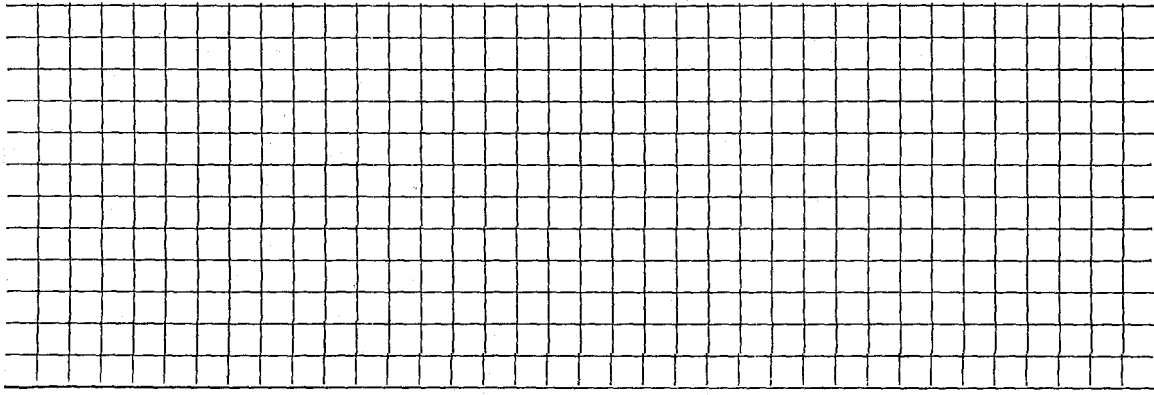

Connection made in _____ Street.

Work completed _____ 19

Remarks: