

Name Sylvia Viano

Service No. ~~57~~ 2748

Address 1798 Mass. Avenue, Lexington

# 5959

Location

14 Vine Brook Road

# 6463

Kind of Pipe

Size

Size of Main

Repair—Renewal—New Service

Location

Date 1939	Material	Amount	Total	Date	Amount
Oct. 7	2 hrs. @ 60¢	1 20		October 9, 1939	25 00
<i>Con</i> 10/30/39	10% Overhead	12	1 32		
	54' 3.4" Copper tubing @ 15¢	15	8 10	November 2, 1939	11 85
	1 3/4" C. x 1/2" I.S. & W.		2 10		13 15
	1 3/4" C. Union (3 part)		88		
	1 hr. trucking @ 75¢		75		
			13 15		
	<b>Labor</b>				

Hadley Press, Inc., Lexington

DATE Oct. 5-1939

# TOWN OF LEXINGTON—BOARD OF PUBLIC WORKS

## WATER DIVISION

The undersigned applies for a supply of water at No. 14 Vane Brook Rd St. and hereby agrees to comply with the rules and regulations as now, or at any future time, established by the Board of Selectmen.

Am't. of Estimate \$ 25<sup>00</sup>


Owner Sylvia Keane

Am't. Paid \$ \_\_\_\_\_

Address 1798 Mass Ave

Builder \_\_\_\_\_

Sketch of Service Here

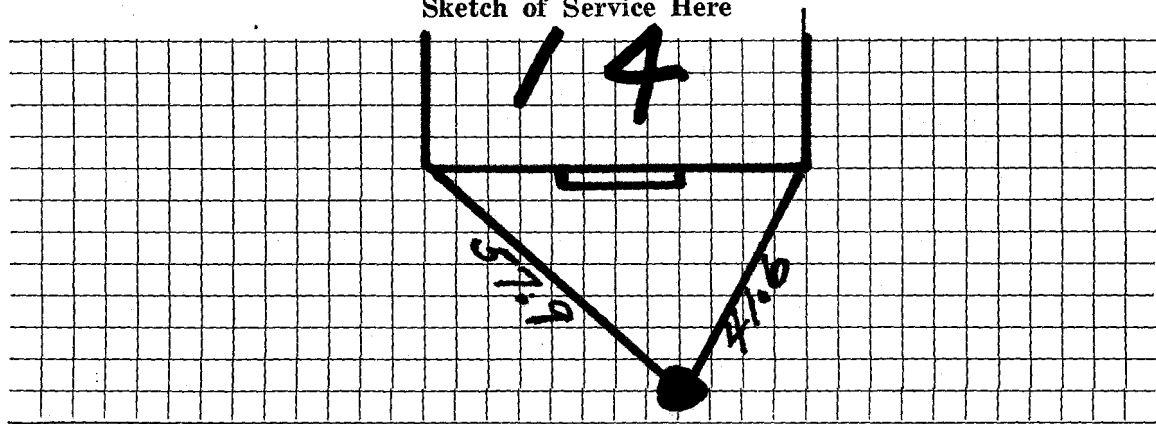

9/25  
25/00

Connection made in \_\_\_\_\_ Street.

Work completed \_\_\_\_\_ 19

Remarks: