


DATE _____

TOWN OF LEXINGTON — BOARD OF PUBLIC WORKS

WATER DIVISION

Sketch of Service Here

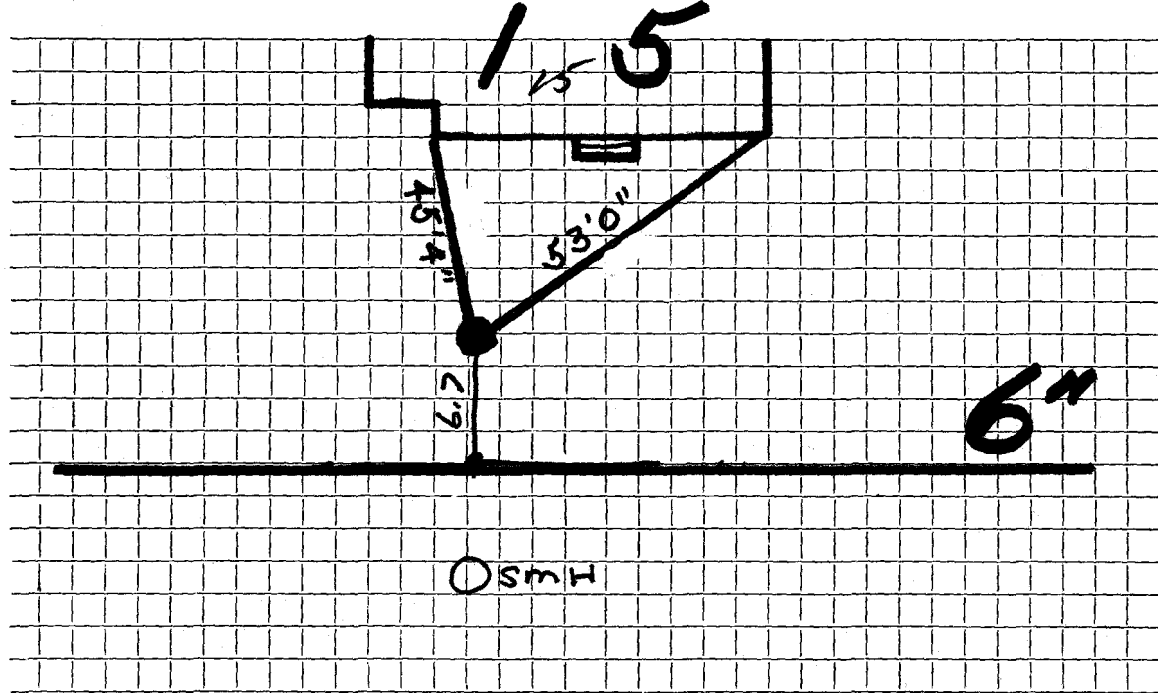

Connection made in Street. Work completed ... 7-19-90

Remarks: Corp. 4.4 deep @ Main

Curb in grass plot between sidewalk + street