

WATER SERVICE RECORD

Name Ivar A. Neilsen

Service No. 2

Address 16 Vine Brook Road

Location

~~Repair~~ Renewal ~~New Service~~ W.O. # 9384


Date	Material	Amount	Total	Date	Amount
4/14/71	Labor		36 72	4-1-71	Deposit 260 00
10%	O.H.		3 67	7-26-71	Refund 168 02
41'	3/4" Copper pipe .79		32 39		91 98
1	3/4" Wheel Valve		9 70		<u>OUTSIDE</u>
1	Hr. Trucking		3 00	4/14/71	Labor 65 66
1	Hr. Shovel		6.50	4/23/71	" 30 81
			91 98	23'	3/4" Copper pipe .79 18 17
				1	3/4" Adapter 2 76
				1	3/4" Curb Cock 11 32
				1/2	Ton Cold patch 8.00 4 00
				2	Ton hot top 7.45 14 90
				2 1/2	Hrs. Trucking 3.00 7 50 1.50 75
				2	" Shovel 4.00 8 00
				1	" Compressor 3 00
				1/2	" Roller 2.00 1 00
					Trailer 2 00
					<u>169 87</u>

DATE _____

TOWN OF LEXINGTON -- BOARD OF PUBLIC WORKS

WATER DIVISION

Sketch of Service Here

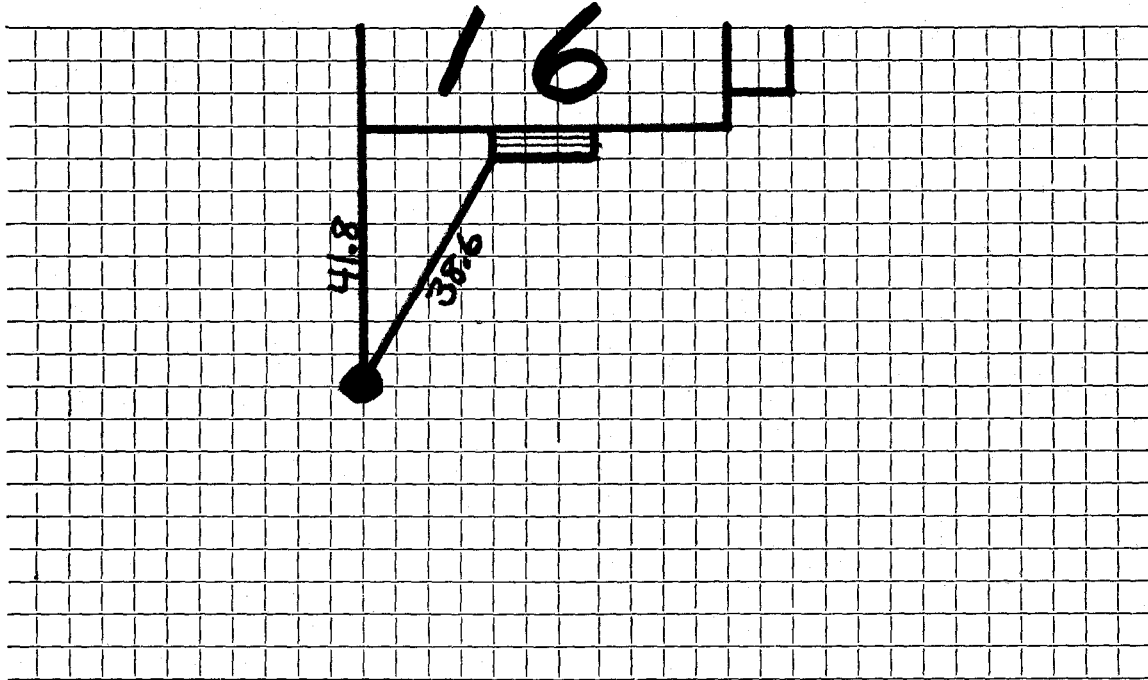

Connection made in Street. Work completed

Remarks:
.....
.....