




TOWN OF LEXINGTON — BOARD OF PUBLIC WORKS  
WATER DIVISION

Sketch of Service Here

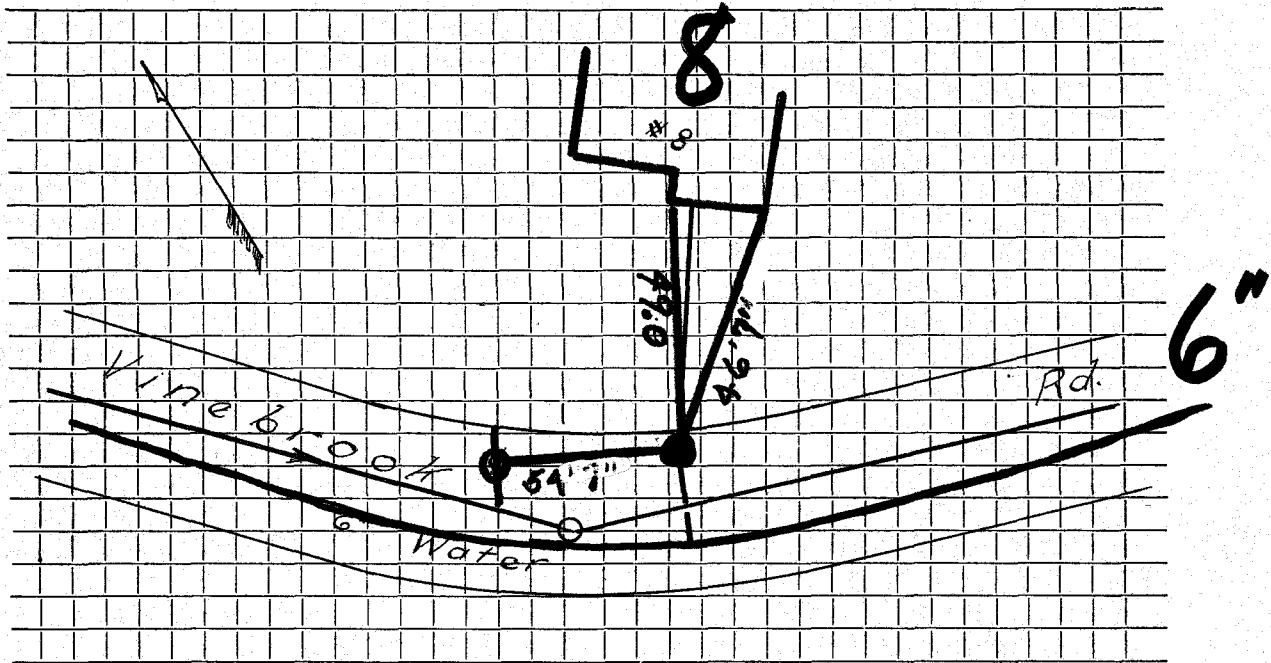

Connection made in ..... Street. Work completed .....

Remarks: .....  
Sept 1, 1953 Repair made to service  
3 ft. UNION install 3' from main