
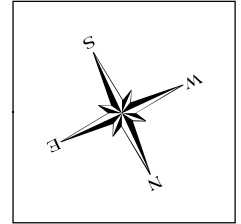


Water Service Tie Card
TOWN OF LEXINGTON
 MASSACHUSETTS

9 Vine Brook Road

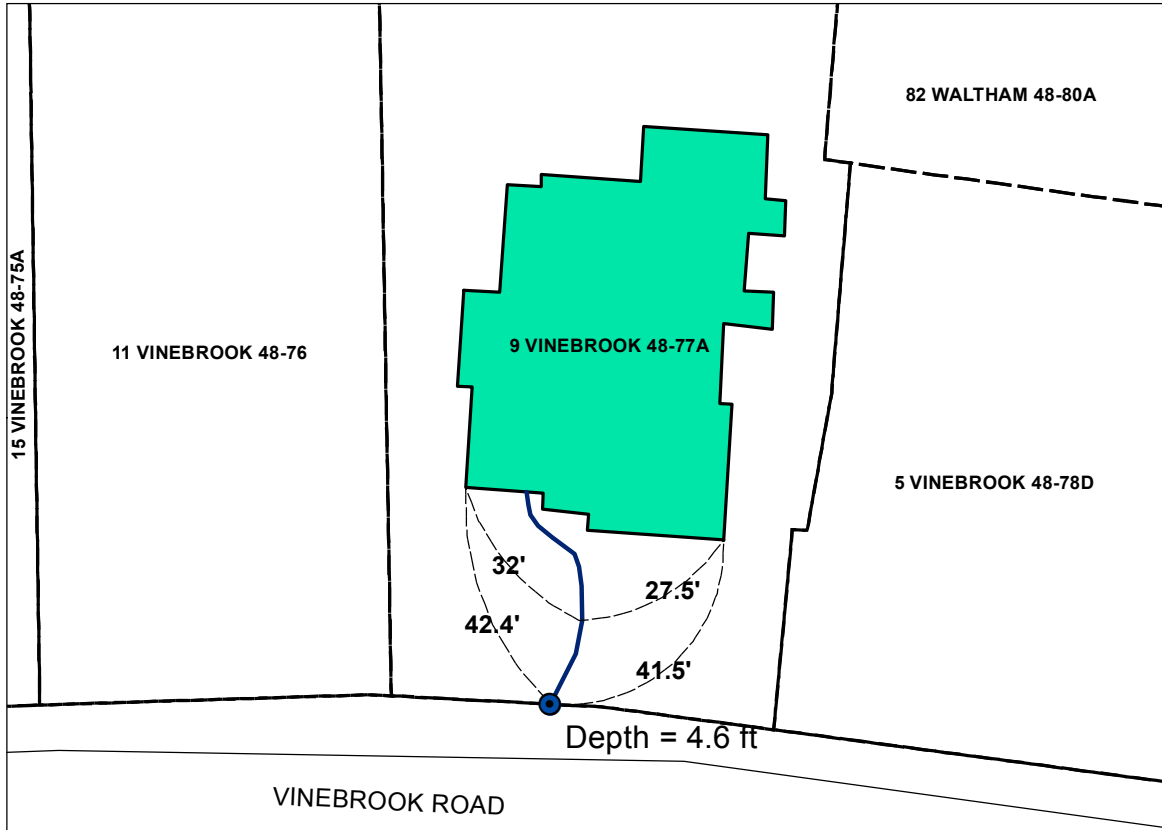

Legend	
	Curb Stop
	Ties_Dimensions
	Water Service Line
	Property Line
	Edge of Pavement

Address	Map and Lot	Permit Number	Contractor Name	Inspector
9 Vine Brook Road	48-77A	5458	J. W. Sullivan Corp.	D. Pavlik

Date:	Material	Amount
11/1/13	1" Copper type "k"	52 Feet

Type of work completed
 New 1" water service to house from curb stop. New house on lot old house removed.