


TOWN OF LEXINGTON - BOARD OF PUBLIC WORKS
WATER DIVISION

Date: 5/20/2001

SKETCH OF SERVICE HERE

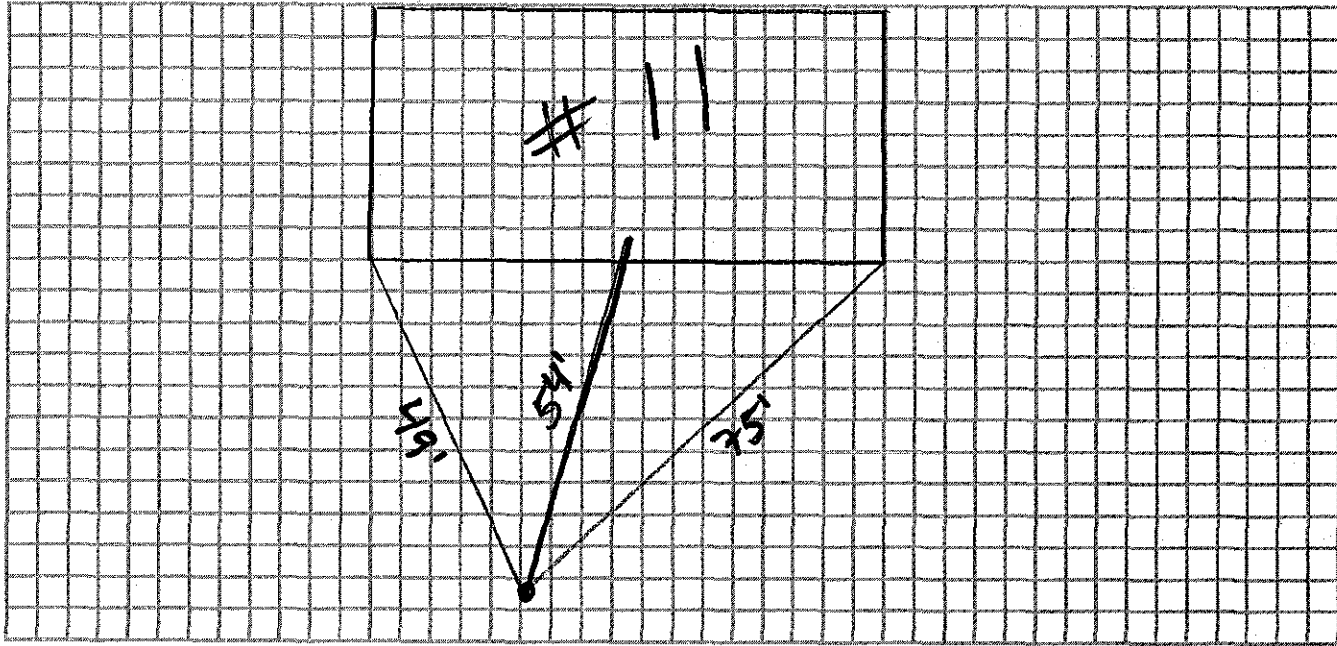

Connection made in:

Volunteer Way

Street:

Work completed:

Remarks: