




DATE 7/16/19

TOWN OF LEXINGTON — BOARD OF PUBLIC WORKS

WATER DIVISION

Sketch of Service Here

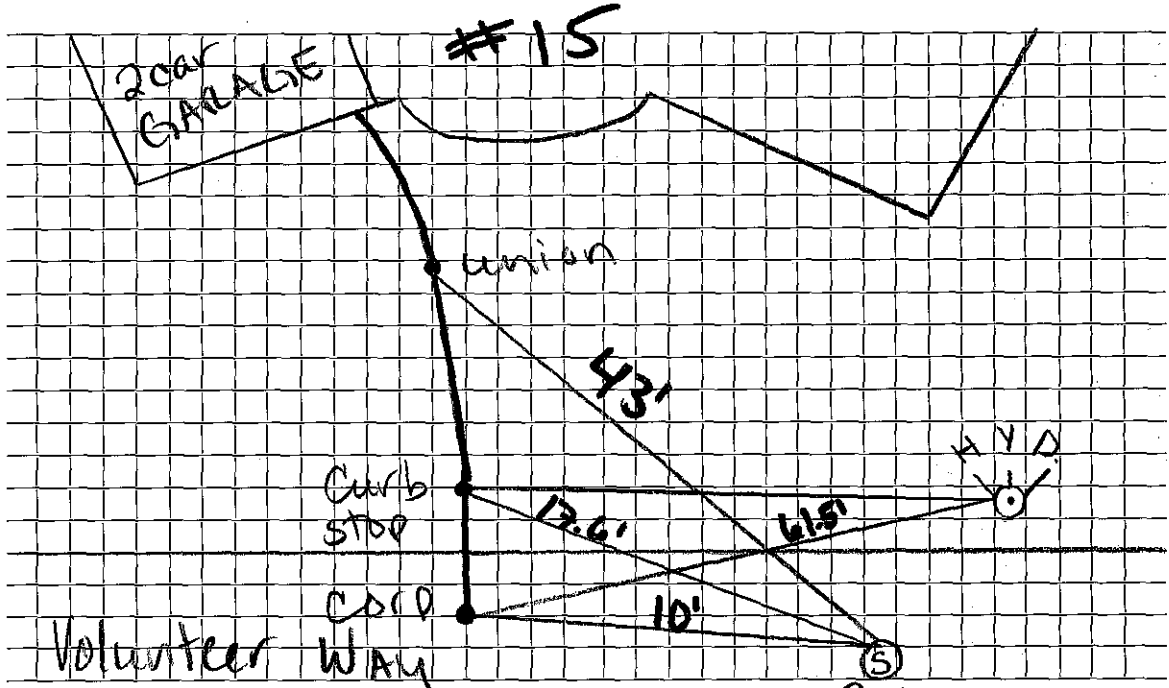

Connection made in Volunteer Way Street. Work completed SMH

Remarks: upgraded to 1.5" copper - approved by Water Supt.  
corp. w/ saddle crosses over sewer 11" above,  
4' depth