


DATE 9-13-'90

TOWN OF LEXINGTON — BOARD OF PUBLIC WORKS

WATER DIVISION

Sketch of Service Here

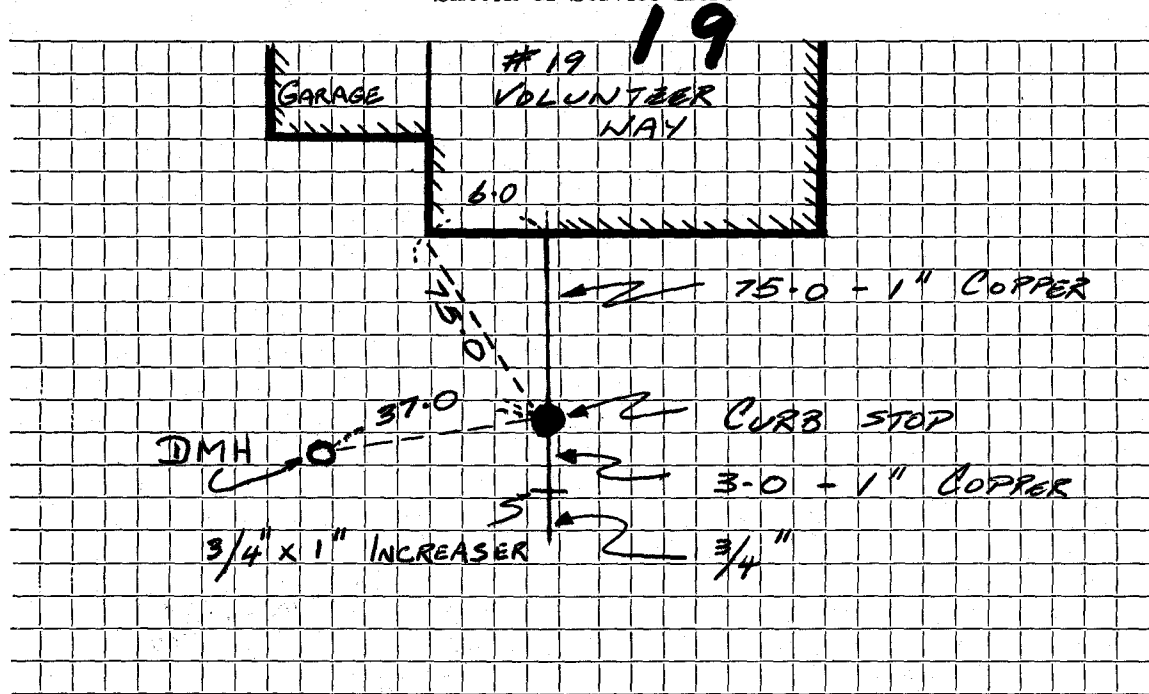

Connection made in ... VOLUNTEER WAY Street.

Work completed

Remarks:
.....
.....