

WATER SERVICE RECORD

Name Robert Larrssen Service No. 261

Address ~~XXXXXXXXXXXX~~ 21 Volunteer Way

Location

~~XXXXXXXXXXXX~~ - New Service *Com 12-13-54*


Date	Material	Amount	Total	Date	Amount
10-25-54	Labor	11 08		10-18-54	Deposited 60 00
	10% overhead	1 11	12 19	12-13-54	Refunded (7 36
	52'-3/4" copper tubing @.35		18 20		<u>NON CHARGE</u> 52 64
	1-3/4 I.W.H. stop & waste		4 00	10/25/54	Labor 11 09
	2 1/3 hr. Littlefield Shovel	@ 7.50	17 50		1 1/4'-3/4" copper tubing @.35 4 90
	1 hr. trucking		75		1-3/4 corp-cock 4 33
			52 64		1-3/4 curb-cock 4 67
					1 box & rod 3 90
					1-1/2 offset tail pc. 50
					1-1/2 straight tail pc. 50
					1 hr. Littlefield shovel 7 50
					1 hr. trucking 75
					<u>38 14</u>

DATE \_\_\_\_\_

TOWN OF LEXINGTON — BOARD OF PUBLIC WORKS

WATER DIVISION

Sketch of Service Here

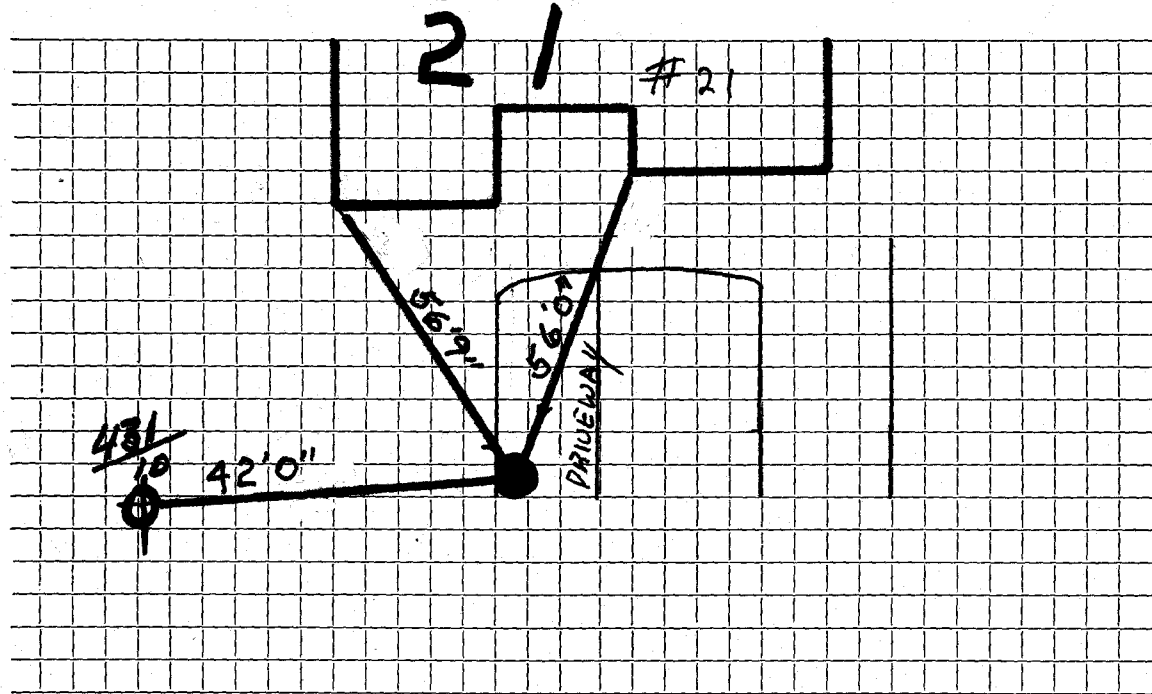

Connection made in ..... Street. Work completed .....

Remarks: .....

.....

.....