


TOWN OF LEXINGTON — BOARD OF PUBLIC WORKS

WATER DIVISION

Sketch of Service Here

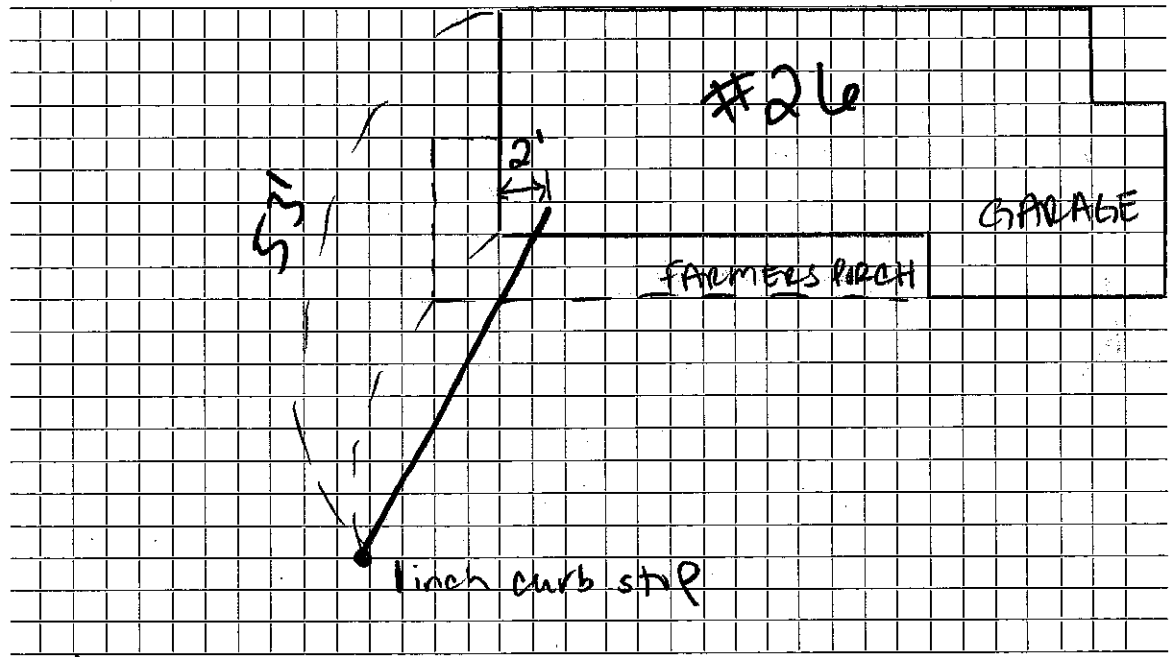

Connection made in... Volunteer Way... ~~Street~~ Work completed

Remarks: