

#4185

WATER SERVICE RECORD

Name Richard Tringale

Service No. 168

Address ~~XXXXXXXXXXXX~~ ~~XXXXXXXXXXXX~~ 27 Volunteer Way

Location

~~XXXXXXXXXXXX~~ - New Service WO #7746

Comm 1-14-63


Date	Material	Amount	Total	Date		Amount
11-30-62	Labor	6.96		11-27-62	Deposit	150.00
	10% O.H.	.70	7.66	1-14-63	Refund	101.34
70'	3/4" Copper tubing @42		29.40			48.64
1	3/4" CX 1/2 I.W.H. Stop & Waste		6.17			
1	3/4" C3 Part Union		2.41		NON CHARGE	
1	Hr. Trucking @3.00		3.00	11-30-62	Labor	20.88
			48.64			
	TRENCH DUG BY OWNER			20'	3/4" Copper tubing @42	8.40
				1	3/4" C Corp Cock	4.91
				1	3/4" C Curb Cock	6.28
				1	Box & Rod	4.90
				1	1/2 Straight Tailpiece	.50
				1	1/2 Offset Tailpiece	.50
						46.37

DATE _____

TOWN OF LEXINGTON — BOARD OF PUBLIC WORKS

WATER DIVISION

Sketch of Service Here

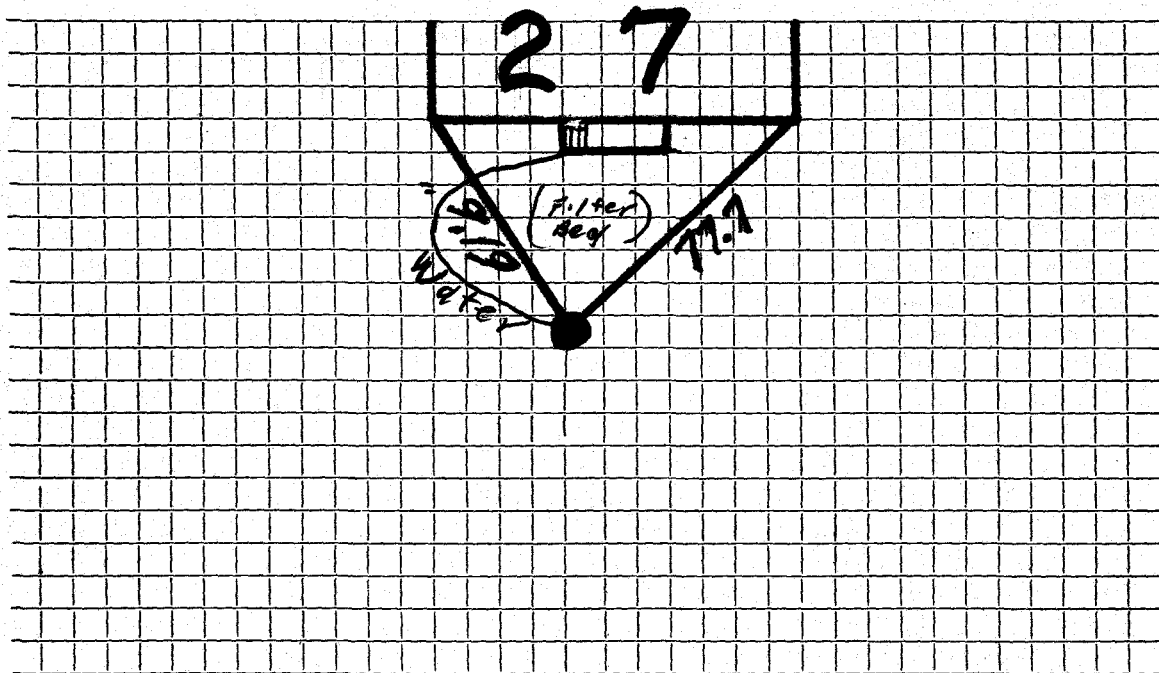

Connection made in Street. Work completed

Remarks:

.....

.....