

#5027<sup>50</sup>Name **Five E's Real Estate Trust**

Service No. 50

Address **#28 Volunteer Way**Location **Sta 4+25 left**Repair—Renewal—New Service **Russell Sibley 724**


SEP 5 1967

Date	Material	Amount	Total	Date	Amount
8-7-67	32' 3/4" Copper tubing			8-7-67	Deposit 105.15
					NON CHARGE
				8-21-63	Labor 32.85
				90'	3/4" Copper tubing @.42 37.80
				1	3/4" C Corp Cock 4.91
				1	3/4" C Curb Cock 6.28
				1	Box & Rod 4.90
				1	3/4" C 3 part union 2.41
				2	hrs. Town Shovel @6.50 13.00
				1	hr. Trucking @3.00 3.00
					105.15

TOWN OF LEXINGTON — BOARD OF PUBLIC WORKS

WATER DIVISION

Sketch of Service Here

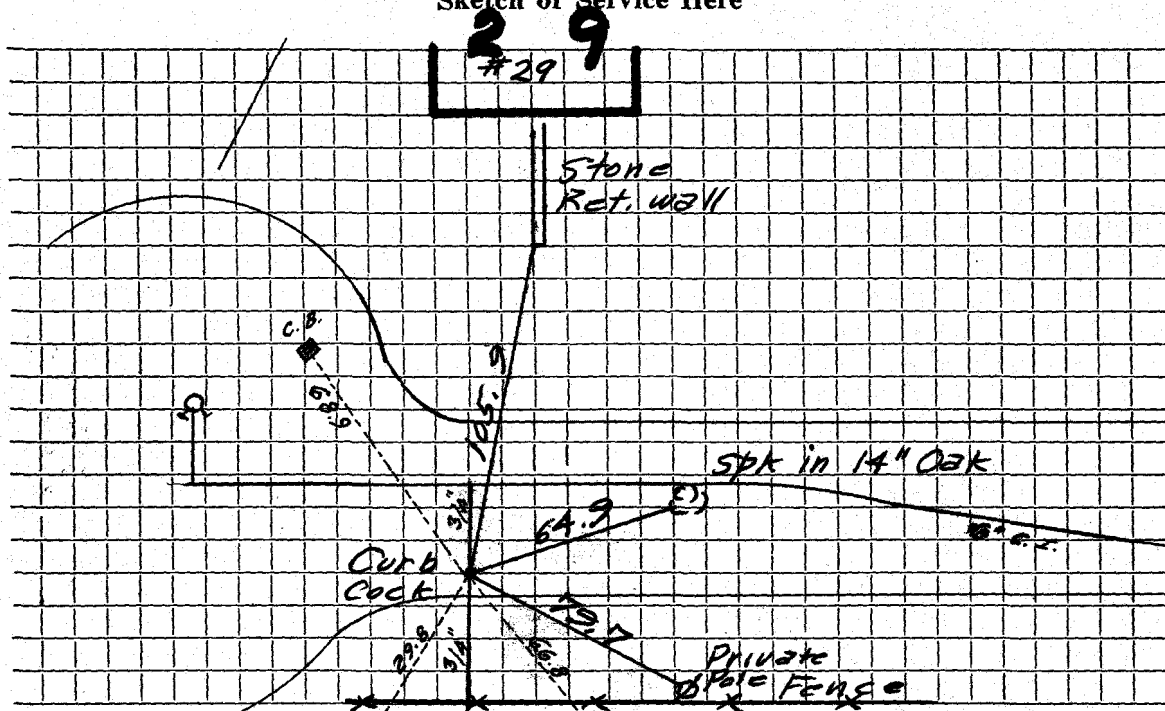

Connection made in ..... Street. .... Work completed .....

Remarks: .....

28  
#28