




DATE \_\_\_\_\_

TOWN OF LEXINGTON — BOARD OF PUBLIC WORKS  
WATER DIVISION

Sketch of Service Here

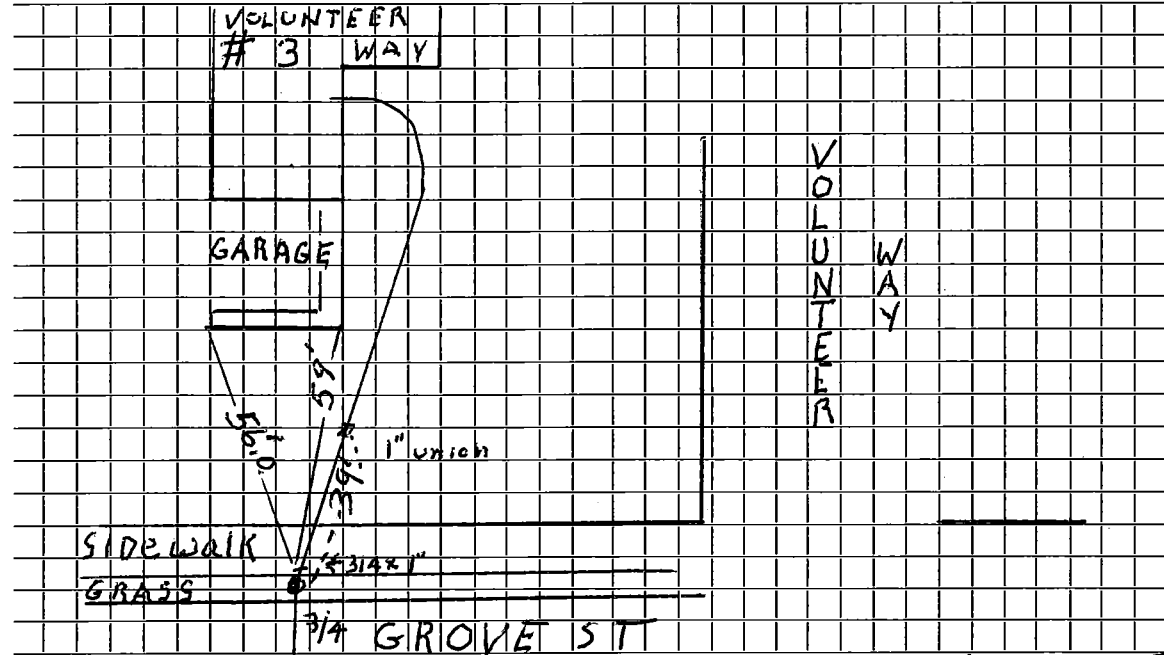

Connection made in Grove St Street. Work completed 4/2011-Tocci

Remarks: .....

.....

.....