

## WATER SERVICE RECORD

1586

Name Reginald Wood

Service No. #22

Address ~~1234567890~~ 30 Volunteer Way

Location Lot #8

~~RENEWAL~~—New Service

W.O. #7107

Comm 6-25-62


Date	Material	Amount	Total	Date	Amount	
4-11-62	Labor	2.45		7-3-62	Deposit	50.00
	10% O.H.	.25	2.70	4-25-62	Returned	12.93
	60' 3/4" Copper Tubing @ .42		25.20			37.07
	1 3/4" C X 1/2 I.W.H. Stop & Waste		6.17			
	1 Hr. Trucking @ 3.00		3.00		Curb to Main	
			37.07	4-11-62	Labor	13.45
	(Owner dug trench)				20' 3/4" Copper Tubing @ .42	8.40
					1 3/4" C Corp Cock	4.91
					1 3/4" C Curb Cock	6.28
					1 Box & Rod	4.90
					1 1/2 Straight Tailpiece	.50
					1 1/2 Offset Tailpiece	.50
						38.94

DATE \_\_\_\_\_

TOWN OF LEXINGTON — BOARD OF PUBLIC WORKS

WATER DIVISION

Sketch of Service Here

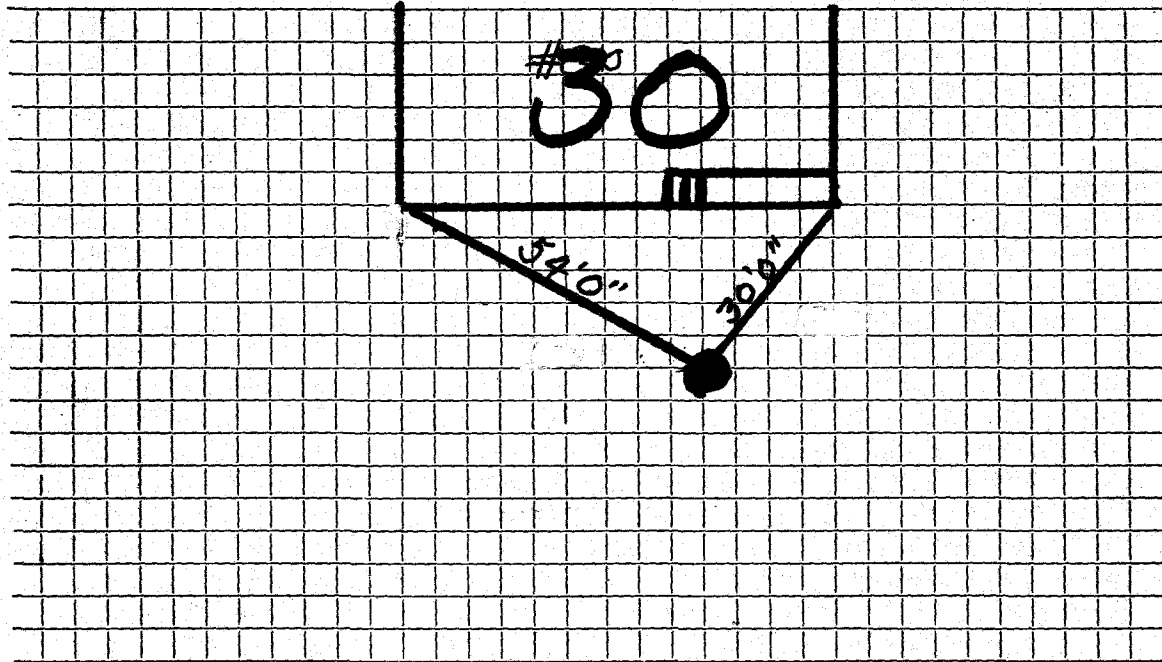

Connection made in ..... Street. Work completed .....

Remarks: .....

.....

.....