


DATE _____

TOWN OF LEXINGTON — BOARD OF PUBLIC WORKS

WATER DIVISION

Sketch of Service Here

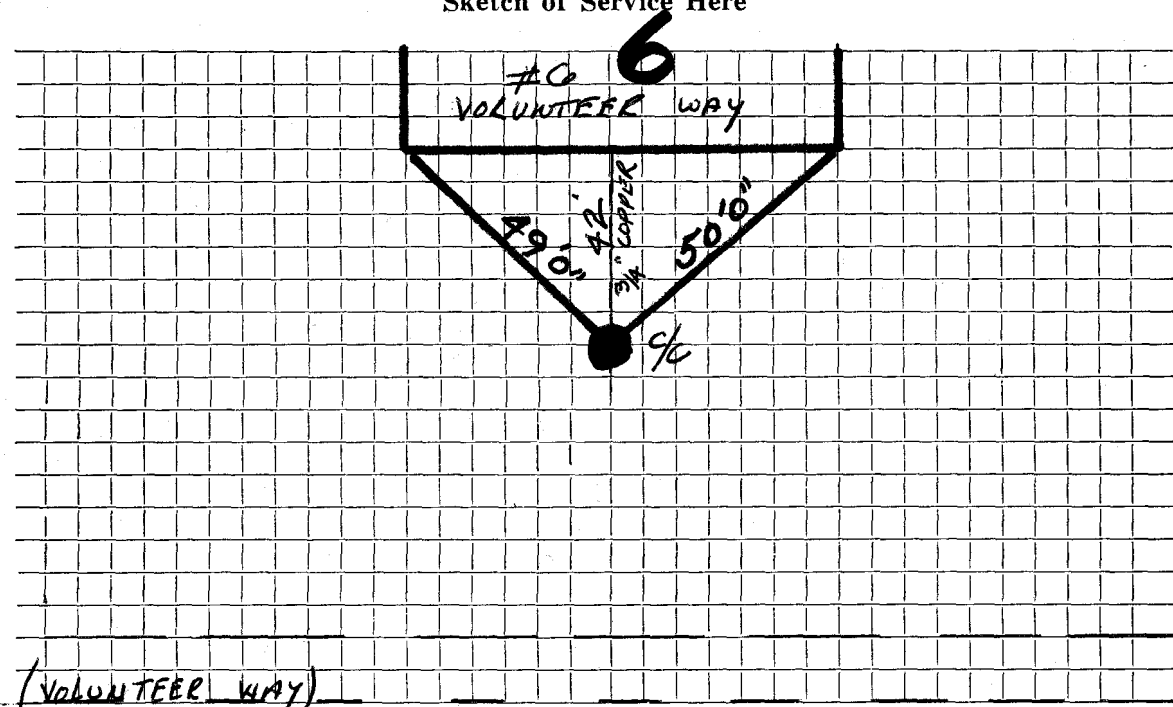

(VOLUNTEER WAY)

Connection made in ..VOLUNTEER..WAY..... ~~Street~~ Work completed

Remarks: SERVICE... WAS... NOT... INSPECTED... BY... THE... TOWN.....

.....
.....