

WATER SERVICE RECORD

#5002

Name ~~XXXXXXXXXX~~ Wilbur Thies

Service No. 193

Address ¹⁶⁴ ~~180 XXXXXXXXXXXX~~ (changed from 160 to 164 Winter St. on 5-4-55, per Engineering Dept.)

Location 7 Volunteer Way

~~XXXXXXXXXX~~ - New Service

Com 9-13-54


Date	Material	Amount	Total	Date	Amount
8/13/54	Labor	4 73		<i>8-13-54 Deposited</i>	<i>50 00</i>
	10% overhead	47	5 20	<i>9-13-54 Refunded</i>	<i>(12 10)</i>
	37' - 3/4" copper tubing@ .35		12 95		<u>NON CHARGE</u>
	1 - 3/4"C x 1/2 I.W.H. stop & waste		4 00	8/13/54 Labor	2 00
	2 hrs. Littlefield shovel@ 7.50		15 00	10' - 3/4" copper tubing@ .35	3 50
	1 hr. trucking		75	1 - 3/4"C. corp-cock	4 33
			37 90	1 - 3/4"C. curb-cock	4 67
				1 box and rod	3 90
				1 - 1/2 straight tail pc.	50
				1 - 1/2 offset tail pc.	50
				1 hr. trucking	75
					<u>20 15</u>

DATE _____

TOWN OF LEXINGTON — BOARD OF PUBLIC WORKS

WATER DIVISION

Sketch of Service Here

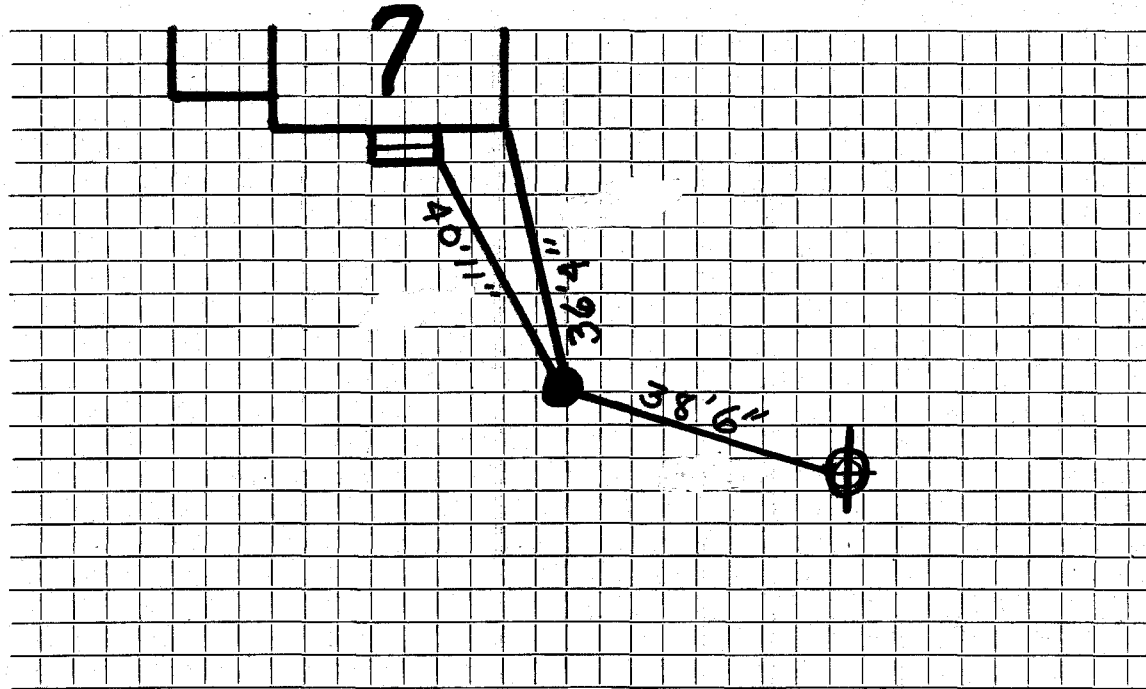

Connection made in Street. : Work completed

Remarks:
.....
.....