

WATER SERVICE RECORD

Name

~~DELETED NEW YORK WATER SUPPLY COMPANY~~ Carl B. Drevitson, Jr.

Service No.

262

Address

~~102 W. 125th Street~~

9 Volunteer Way

Location

Repair—Renewal—New Service

Comm. 11-19-56

Date	Material	Amount	Total	Date	Amount
8/28/56	Labor	8 80		8-27-56	Deposit # 100 00
8/31/56	Labor	13 87		11-19-56	Refund 13 50
	10% overhead	2 27	24 94		<u>NON CHARGES</u> 86 50
	60' 3/4" copper tubing @.4850		29 10	Labor	5 07
	1 3/4"C x 1/2" I.W.H. stop&waste		4 96	12' 3/4" copper tubing @.4850	5 82
	2 hr. trucking @ .75		1 50	1 3/4"C Corp Cock	4 64
	4 hrs. Town Shovel @ 6.50		26 00	1 3/4"C Curb Cock	5 94
			86 50	1 Box & Red	4 62
				1 1/2 Straight tail piece	50
				1 1/2 Offset tail piece	50
				2/3 hrs. Town Shovel @ 6.50	4 34
				1 hr. trucking @ .75	75
					<u>32 18</u>


403

404

TOWN OF LEXINGTON — BOARD OF PUBLIC WORKS

WATER DIVISION

Sketch of Service Here

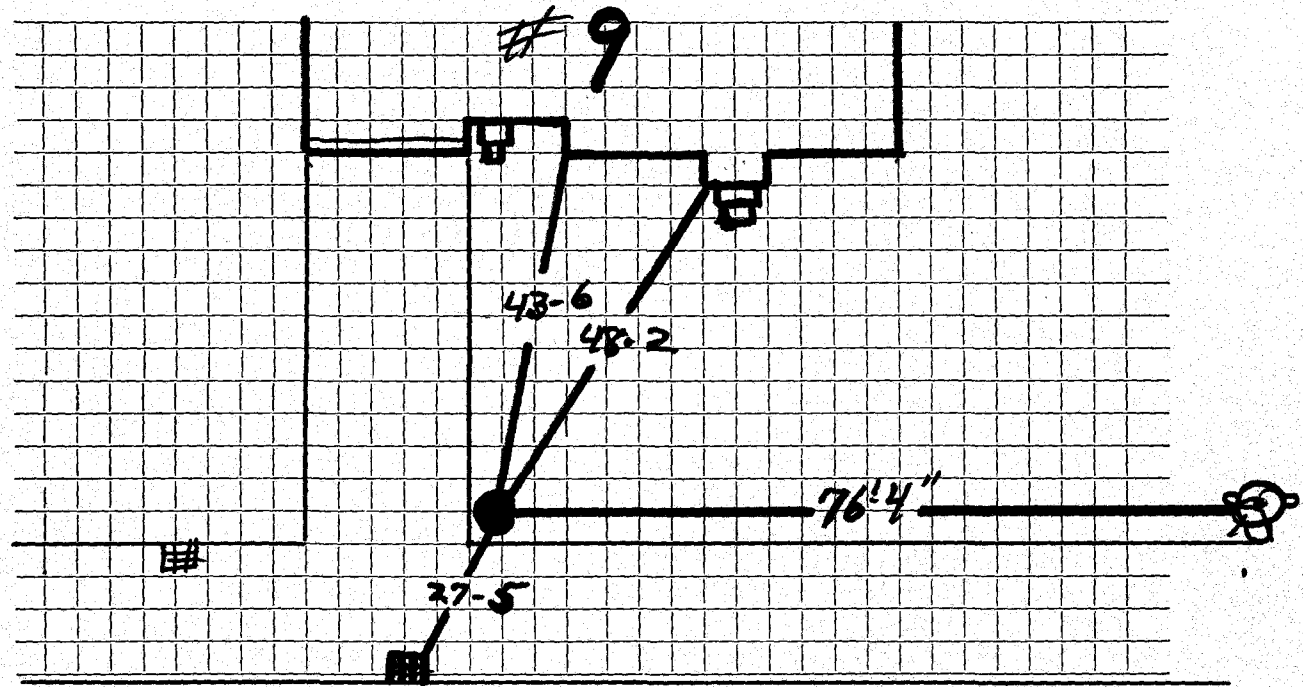

Connection made in Street. Work completed

Remarks:
.....
.....