

WATER SERVICE RECORD

Name Oscar W. Carlson

Service No. 189

Address 1 Wachusett Drive

6913

Location

HOMEPACONMIX—New Service


Com. 8-10-53

Date	Material	Amount	Total	Date		Amount
7/14/53	Labor	6 50		7-9-53	Deposited	100 00
	10% overhead	65	7 15	7-8-53	Paid	(13 99)
	230' - 1" copper tubing @ .3997		91 93		<u>NON CHARGE</u>	113 99
	1 - 1" C x 3/4" I.W.H. stop & waste	5 12	7/14/53 Labor			13 36
	4 - 1" Cx 1"C. unions @ 2.26	9 04	7' - 1" copper tubing @ .3997			2 80
	1 hr. trucking	75	1 - 1" C. corp-cock			5 61
	TRENCH DUG BY OWNER:		113 99	1 - 1" C x 1" C. curb-cock		6 80
				1 - box and rod		3 90
				1 - 3/4" Straight tail piece		50
				1 - 3/4" offset tail piece		50
				3 hrs. Littlefield shovel @ 7.50 -	22 50	
				1 hr. trucking		75
						56 72
						<i>bill sent 8-14-53</i>

DATE _____

TOWN OF LEXINGTON - BOARD OF PUBLIC WORKS
WATER DIVISION

Sketch of Service Here

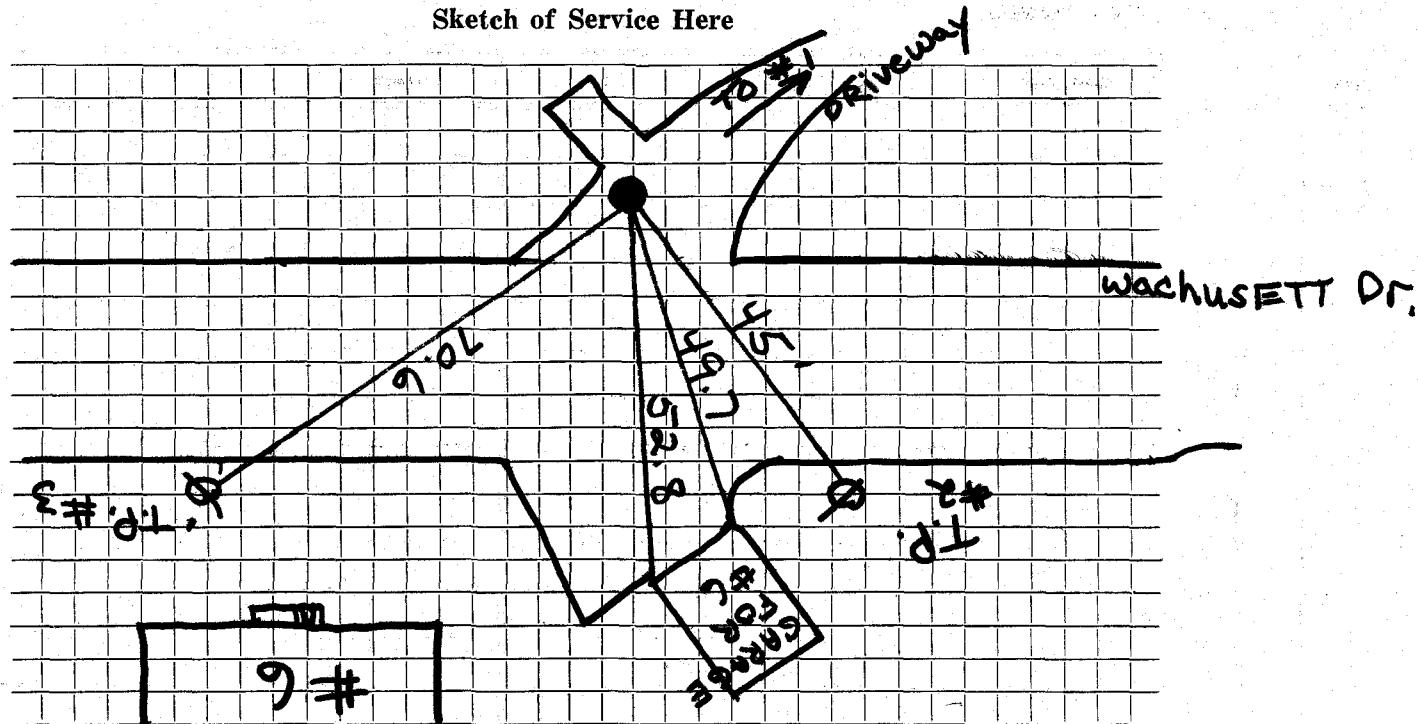

Connection made in Street. Work completed

Remarks: