

WATER SERVICE RECORD

Name Oscar Carlson

Service No. 2

Address 19 Wachusett Drive

4899

Location Lexington

~~Repair/Replacement~~ New Service

COM. 2-4-52


Date	Material	Amount	Total	Date	Amount
1/28/52	Labor	4 03	4 03	1-18-52 Deposited	40 00
	10% overhead		40	2-4-52 Revised	0 00
	42' -3/4" copper tubing @ .3439	14 44			39 34
	1 - 3/4" C x 1/2 I.W.H. stop&waste	4 00		1/28/52 Labor	7 42
	1 - 3/4" C x 3/4" C.union 3 pts.	1 72		22' - 3/4" copper tubing @.3439	7 56
	2 hrs. Littlefield shovel	14 00		1 - 3/4" C. corp-cock	4 33
	1 hr. trucking		75	1 -3/4" C x 3/4" C.curb-cock	4 67
			39 34	1 box and rod	4 52
				1 -1/2 offset tail piece	50
				1 - 1/2 straight tail piece	50
				3 hrs. Littlefield shovel	21 00
				1 hr. trucking	75
					51 25

DATE _____

TOWN OF LEXINGTON — BOARD OF PUBLIC WORKS

WATER DIVISION

Sketch of Service Here

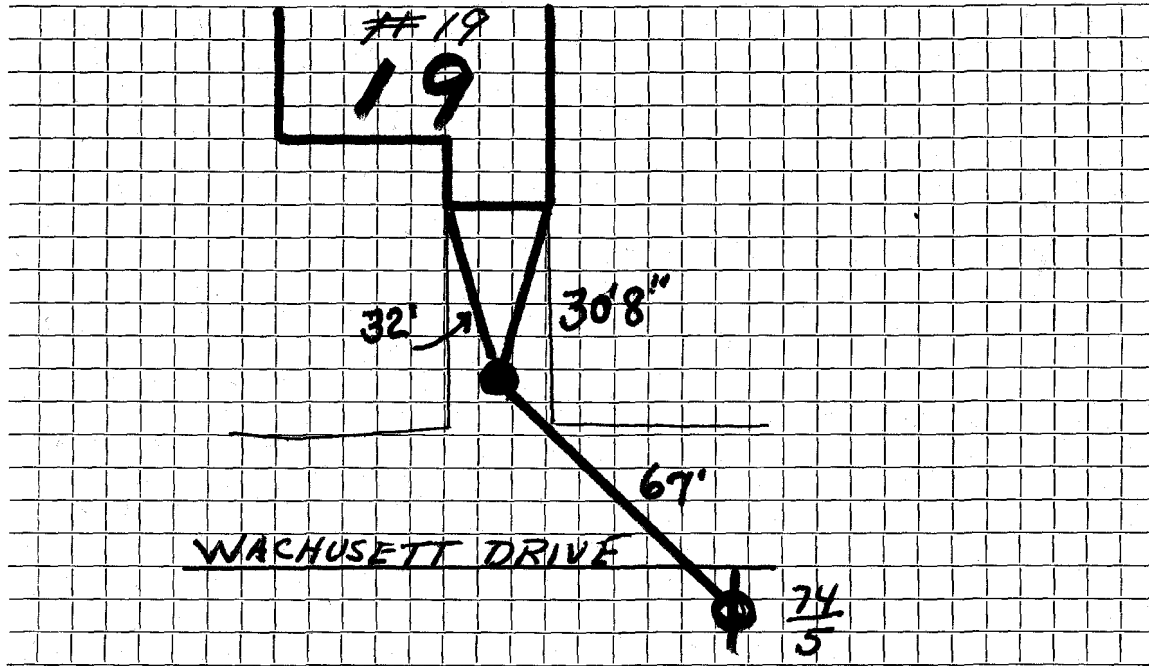

Connection made in Street. Work completed

Remarks:

.....

.....