

Name Lester H. Olson

Service No. 256 269

Address 21 Wachusett Drive

Lexington, Mass.

Location 21 Wachusett Drive

Kind of Pipe

Size

Size of Main

~~Repair~~ ~~Renewal~~ - New Service

Com. 3-6-50

Location

| Date | | Material | Amount | Total | Date | Amount |
|--------|-----|------------------------------|--------|-------|------------|-------------------------------|
| Jan. 3 | '50 | Labor | 6 40 | | Jan. 5 '49 | 40 00 |
| | | 10% Overhead | 64 | 7 04 | Mar 9 50 | 8 12 |
| | | 60'- 3/4" Copper Tubing @.23 | | 13 80 | | 31 88 |
| | | 1- 3/4"C x 1/2" I.W.H. S&W | | 3 29 | | |
| | | 1 hr. Littlefield Shovel | | 7 00 | | Non-Charge |
| | | 1 hr. Trucking | | 75 | | 26'- 3/4" Copper @ Tubing .23 |
| | | | | 31 88 | | 1- 3/4"C. Corp. Cock |
| | | | | | | 3 15 |
| | | | | | | 1- 3/4"C. Curb-Cock |
| | | | | | | 3 85 |
| | | | | | | 1 Box & Rod |
| | | | | | | 3 70 |
| | | | | | | 1- 1/2" Straight Tail Piece |
| | | | | | | 38 |
| | | | | | | 1- 1/2" Offset Tail Piece |
| | | | | | | 38 |
| | | | | | | 2 hrs. Littlefield Sh. 14 00 |
| | | | | | | 1 hr. Trucking |
| | | | | | | 75 |
| | | Labor | | | | 31 49 |

TOWN OF LEXINGTON - BOARD OF PUBLIC WORKS

WATER DIVISION

The undersigned applies for a supply of water at No..... St. and hereby agrees to comply with the rules and regulations as now, or at any future time, established by the Board of Selectmen.

Am't of Estimate \$.....

Owner


Am't Paid \$.....

Address

Builder

.....

Sketch of Service Here

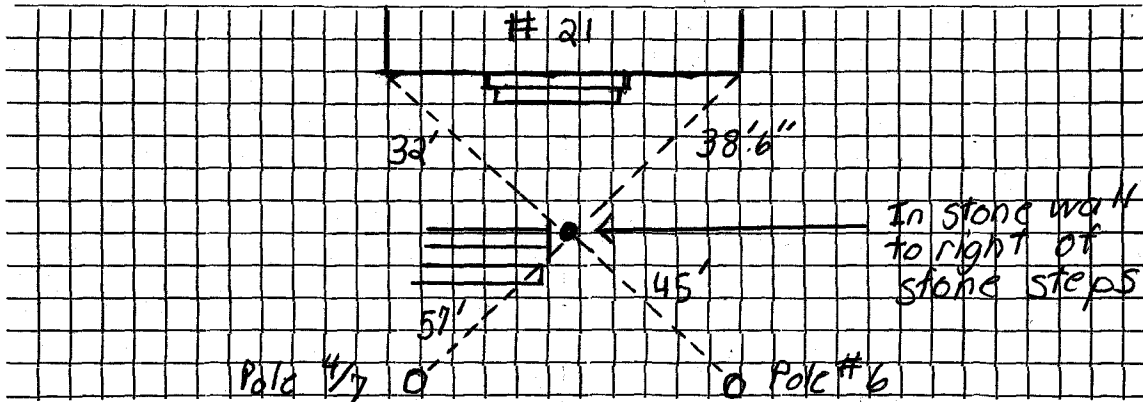

Connection made in Street.

Work completed19

Remarks: