

Name Leslie JohnsonService No. 193Address 26 Wachusett Drive

#1571

Lexington, Mass

Location 26 Wachusett Drive

Kind of Pipe

Size

Size of Main

~~Repair~~ ~~Renewal~~ New ServiceCom. 9-26-49

Location

Date	Material	Amount	Total	Date	Amount	
Aug. 29, '49	Labor	5 00		Aug 23 '49	120 00	
Aug. 31, '49	Labor	22 03		Sept 11 '49	47 81	
Sept. 6, '49	Labor	<u>19 25</u>	46 28		No Charge	
	10% Overhead		4 63	Sept. 7, '49	Labor	29 42
	125' - 3/4" Copper Tubing @.24	30 00			15' - 3/4" Copper Tubing @.24	3 60
	1 - 3/4" C x 1/2" I.W.H. S&W	3 15			1 - 3/4" Corp-cock	3 15
	3 - 3/4" C x 3/4" C Unions	4 17			1 - 3/4" C x 3/4" C Curb-cock	3 85
	Dynamite 25 lbs. @.215	5 38			1 - 1/2" Offset Tail Piece	37
	Exploders 38 @.117	4 45			1 - 1/2" Straight Tail Piece	37
	Compressor 7 hrs. @ 1.75	12 25			Littlefield Shovel 2 hrs. @ 7.00	14 00
	Littlefield Shovel 8hrs. @ 7.00	56 00			Trucking 1 hr. @.75	75
	Trucking 2 hrs. @.75	1 50				<u>55 51</u>
	Labor		167 81			
	<i>Bill sent 10-6-49</i>					

DATE _____

TOWN OF LEXINGTON - BOARD OF PUBLIC WORKS

WATER DIVISION

The undersigned applies for a supply of water at No..... St. and hereby agrees to comply with the rules and regulations as now, or at any future time, established by the Board of Selectmen.

Am't of Estimate \$.....

Owner


Am't Paid \$.....

Address

Builder

.....

Sketch of Service Here

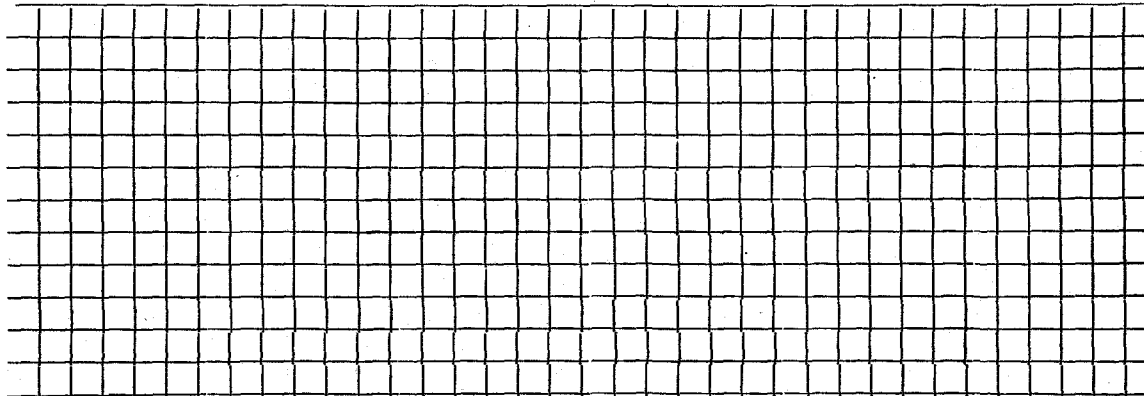

Connection made in Street.

Work completed19

Remarks: