

Name Oscar W. Carlson

Service No. 153

3396

Address 28 Wachusett Drive

2639

Location 28 Wachusett Drive

Kind of Pipe

Size

Size of Main

RENEWAL—New Service

Com 12-1-47

Location

Date	Material	Amount	Total	Date	Amount
Oct. 27, '47	Labor	4 00	4 00	Oct 29 '47	Deposited 35 00
	10% Overhead		40	Dec 4 '47	Refunded 1 00
	45' - 3/4" Copper Tubing @ .26	11 70			Non-Charge 34 00
	1 - 3/4" C x 1/8" I.W.H. S & W	3 15		Oct. 27, '47	Labor 18 00
	Hired Shovel 2 hrs. @ 7.00	14 00		28' - 3/4" Copper Tubing @ .26	7 28
	Trucking 1 hr. @ .75	75		1 - 3/4" C Corp-cock	3 00
			34 00	1 - 3/4" C x 3/4" C Curb-cock	3 68
				Hired Shovel 2 hr. @ 7.00	7 00
				1 - 1/8" Offset Tail Piece	30
				1 - 1/8" Straight Tail Piece	30
				Trucking 1 hr. @ .75	75
					<u>44 57</u>
	Labor				

DATE _____

TOWN OF LEXINGTON - BOARD OF PUBLIC WORKS

WATER DIVISION

The undersigned applies for a supply of water at No..... St. and hereby agrees to comply with the rules and regulations as now, or at any future time, established by the Board of Selectmen.

Am't of Estimate \$.....

Owner


Am't Paid \$.....

Address

Builder

25 Henry St. Bencherley Mass

Sketch of Service Here

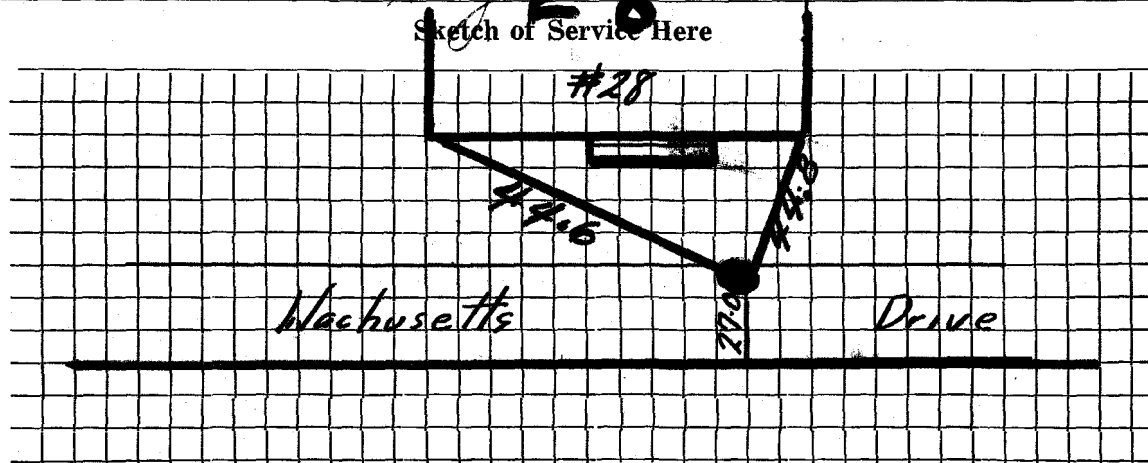

Connection made in Street.

Work completed19

Remarks: