

Name Melanson, Howard E.

Service No. ~~2768~~ 2768

Address ~~219 Brown Street, Waltham~~

29 Wachusett Drive Location

#29 Lot #96 Wachusett Drive

Kind of Pipe

Size

Size of Main

~~Repair - Ransom~~ - New Service

Location

Date	Material	Amount	Total	Date	Amount
1936					
May 14	2 hrs. labor @ 60¢	1 20		May 10 th 1936	30 00
	10% Ovhd. on labor	12		June 30, 1936	12 90
	38' 3/4" Copper @ 15¢	5 70			17 10
	1 Stop & Waste	1 75			
		8 77			
	Chge: 38' @ 45¢		17 10		
	Labor				

Hidley Press, Inc., Lexington

Com. 57.10
to Russell
6-9-36

Deposited
Refunded

DATE May 12, 1936.

TOWN OF LEXINGTON—BOARD OF PUBLIC WORKS

WATER DIVISION

The undersigned applies for a supply of water at No. lot #96 Wachusett Trust and hereby agrees to comply with the rules and regulations as now, or at any future time, established by the Board of Selectmen.

Am't. of Estimate \$ 30.00

Owner

Howard E. Melner.

Am't. Paid \$ _____


Address

219 Brown St.

Builder _____

Waltham

Sketch of Service Here

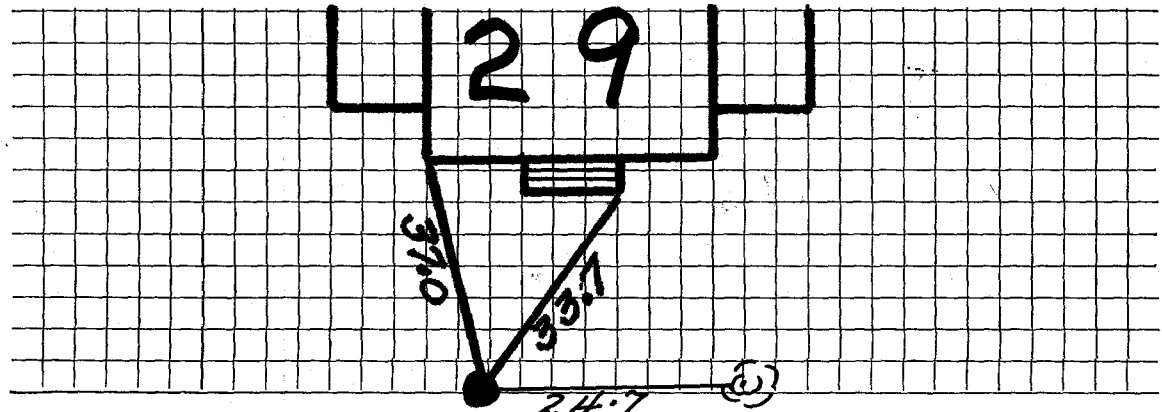

Connection made in _____ Street.

Work completed _____ 19

Remarks:

75
40
30.00