



43'  
50'  
21.50

DATE April 14, 1938

TOWN OF LEXINGTON—BOARD OF PUBLIC WORKS

WATER DIVISION

Lot 77 & 78

The undersigned applies for a supply of water at No. 30 Massachusetts Drive St. and hereby agrees to comply with the rules and regulations as now, or at any future time, established by the Board of Selectmen.

Am't. of Estimate \$ 71.50


Owner Frank Johnson

Am't. Paid \$ \_\_\_\_\_

Address 38 Mare St.

Builder Woliason 17 Phordike St. West, Somerville

Sketch of Service Here

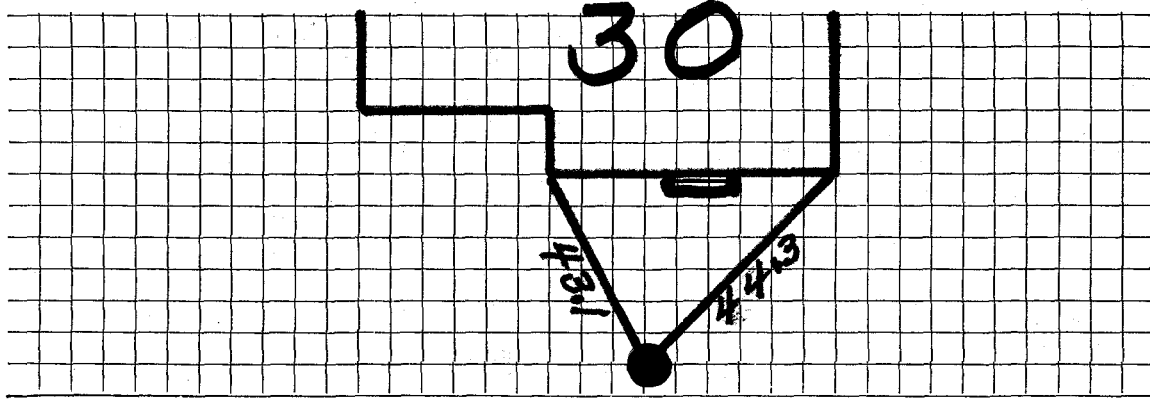

Connection made in \_\_\_\_\_ Street. Work completed \_\_\_\_\_ 19

Remarks: