




DATE DEC 1984

TOWN OF LEXINGTON — BOARD OF PUBLIC WORKS

WATER DIVISION

Sketch of Service Here

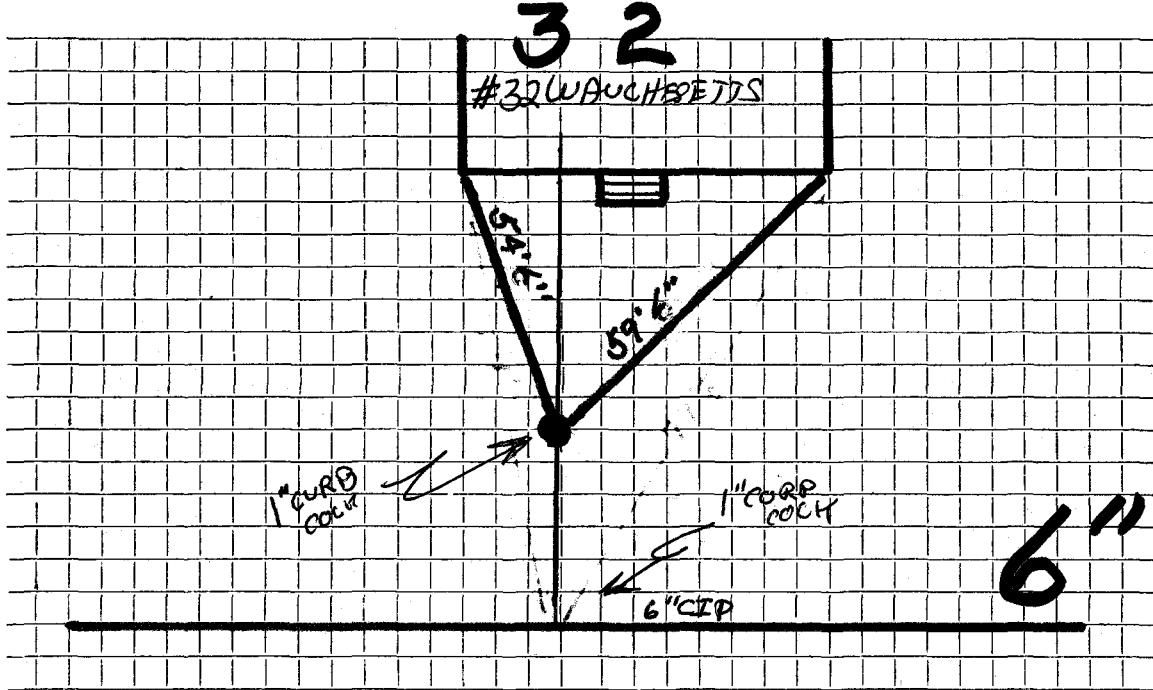

Connection made in WAUCHESETTS DR Street.

Work completed .....

Remarks: .....

.....

.....