

WATER SERVICE RECORD

Name Otis H. Bramhall

Service No. 46

Address #35 WACHUSETT DR.

Location

Repair - ~~WATER SERVICE~~ <sup>no. 3050</sup> Valer's CONST. W.O. #5951

Comm 2-13-28


Date	Material	Amount	Total	Date	Amount	
12/5/77	201' of 1" copper			12-5-77	Deposit	85.00
12/5/77	Labor	13.84			Retain	1.93
	10% D.H.	1.38	15.22			37.08
1	1" Repair Clamp		6.86			
1	1 x 4 C.L. Nipple		.70			
1	1" x 1" 2 part Union		4.25			
1	1" Brass Elbow		3.05			
1	hr. Trucking		3.00			
			33.08			

DATE \_\_\_\_\_

# TOWN OF LEXINGTON — BOARD OF PUBLIC WORKS

## WATER DIVISION

Sketch of Service Here

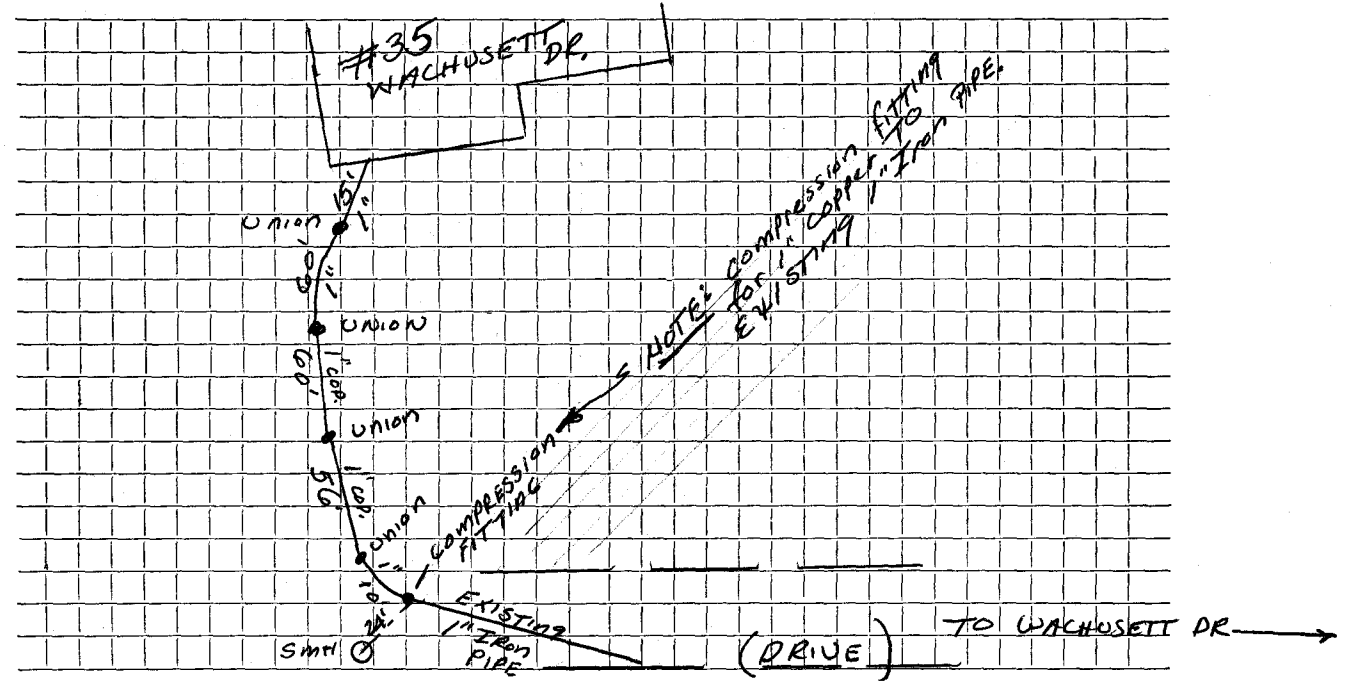

Connection made in ..... Street. Work completed .....

Remarks: .....

.....

.....