


FAIR OAKS DRIVE

DATE _____

TOWN OF LEXINGTON -- BOARD OF PUBLIC WORKS

WATER DIVISION

WACHUSETT DRIVE

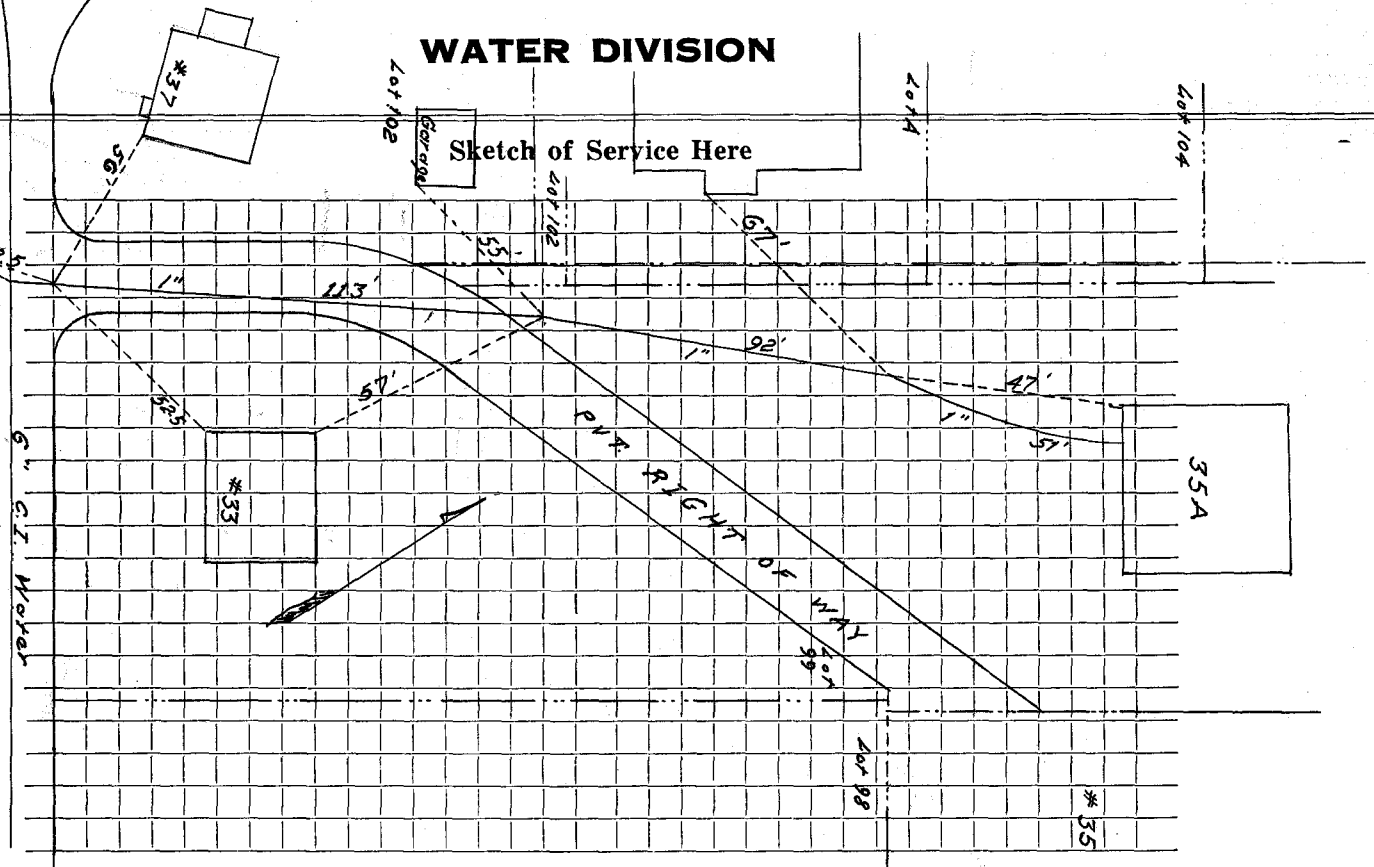

Connection made in Street. Work completed

Remarks:
.....
.....