

Name Elias T. Bears

Service No. ~~2772~~ 2772

Address ~~62 Prospect Hill Road, Lexington,~~

#7094

38 Wachusett Drive Location

38 Wachusett Drive.

Kind of Pipe

Size

Size of Main

Repair—Renewal—New Service

Location

Date

Material

Amount

Total

Date

Amount

Nov. 6, 1940

8 hrs. @ 60¢

4 80

Oct 30, 1940 Deposited

20 00

from 12-31-40.

10% Overhead

48

5 28

48' 1" copper tubing @ 19¢

9 12

1 1" S. & W.

2 25

2 hrs. trucking @ 75¢

1 50

Construction charge

3 75

21 90

Charge: \$20.00.

Labor

Hadley Press, Inc., Lexington

DATE Oct 28 40

TOWN OF LEXINGTON - BOARD OF PUBLIC WORKS
WATER DIVISION

The undersigned applies for a supply of water at No. 38 Wachuset Dr St. and hereby agrees to comply with the rules and regulations as now, or at any future time, established by the Board of Selectmen.

Am't. of Estimate \$ 20.00

Owner Harry L. Nash


Am't. Paid \$ _____

Address Frederick Ave.

Builder E. J. Beans
62 Crispent Hill Rd.

Medford

Sketch of Service Here

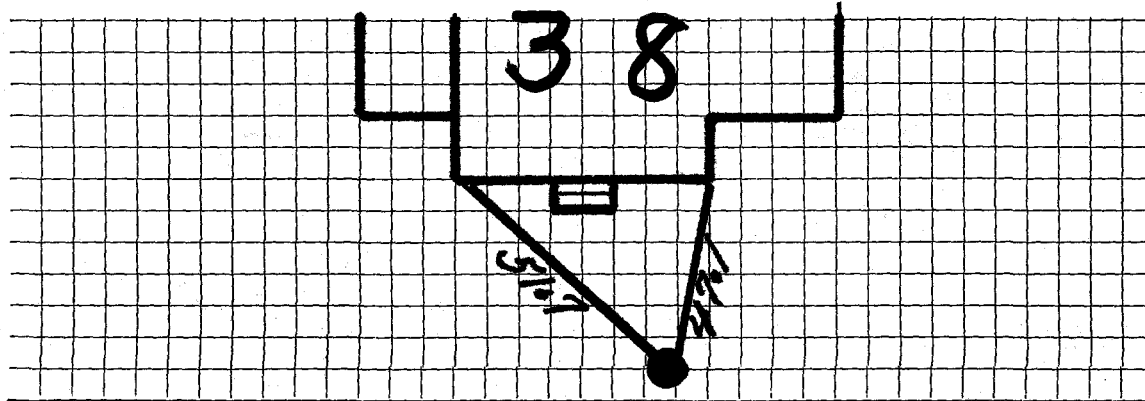

Connection made in _____ Street.

Work completed _____ 19

Remarks: