

WATER SERVICE RECORD

Name **C.L. Sturdevent**

Service No. **316**

Address **40 Wachusett Drive**

Location

~~Repair~~—Renewal—~~New Service~~


*Cam. 12-31-51*

Date	Material	Amount	Total	Date	Amount
12-13-51	Labor	1 49	1 49	12-3-51	Deposited 25 00
	10% Overhead		15	12-31-51	Refunded (2 31)
	50'-3/4" Copper Tubing @.326		16 30		22 69
	1-3/4"Cx1/2 I.W.H. S&W		4 00		No Charge
	1 Hr. Trucking		75	12-13-51	Labor 17 81
	<b>Total</b>		<b>22 69</b>	27'-3/4" Copper Tubing @.326	8 80
				1-3/4"C Corp-Cock	4 33
				1-3/4"Cx3/4" C Curb-Cock	4 67
				1-Box & Rod	4 68
				1-1/2 Offset Tail Piece	50
				1-1/2 Straight Tail Piece	50
				1 Hr. Trucking	75
				<b>Total</b>	<b>42 04</b>

DATE \_\_\_\_\_

TOWN OF LEXINGTON — BOARD OF PUBLIC WORKS  
WATER DIVISION

Sketch of Service Here

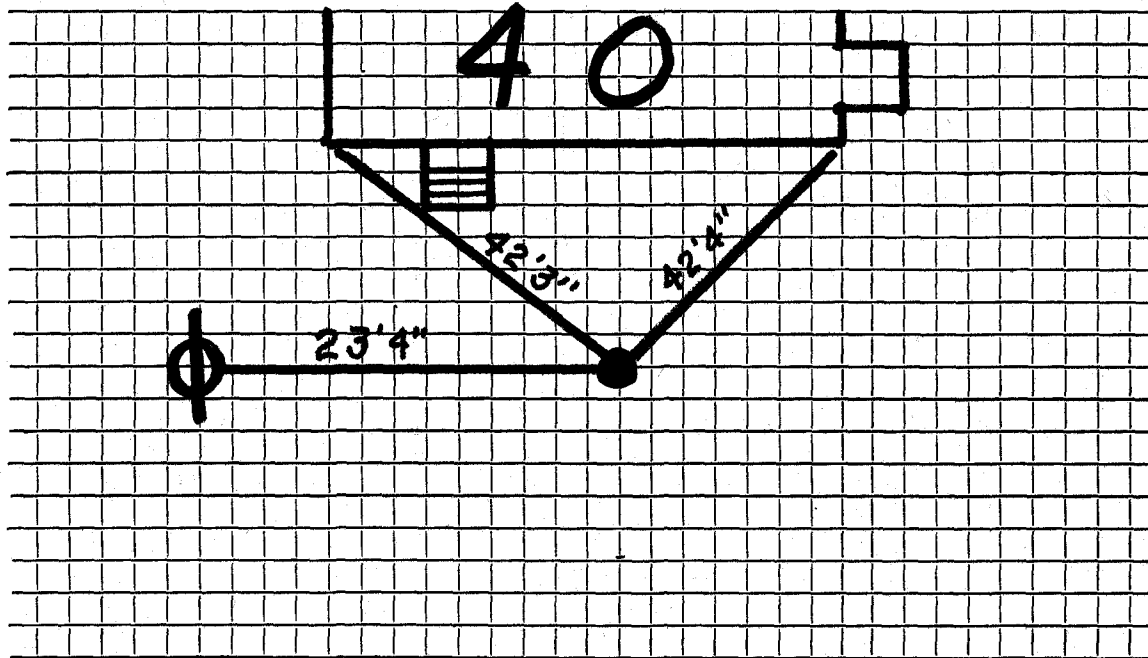

Connection made in ..... Street. Work completed .....

Remarks: .....  
.....  
.....