

Name Merle Miller

194 Mt. Vernon St. Malden

Service No. 2765

Address 42 Wachusett Circle *Circle*

Location *42 Wachusett Drive*

Kind of Pipe

Size

Size of Main

~~Repair~~ ~~Renewal~~ — New Service

Location

Date
1938

Material

Amount

Total

Date

Amount

June

2 hrs. @ 60

1 20

June 16, 1938 Deposited

25 00

35' 3/4" C. Tubing @ 20¢

7 00

July 11, 1938 Refunded

7 50

1 3/4" S. & W.

3 75

1 3/4" Bushing

30

Trucking 2 hrs. @ 75¢

1 50

12 55

Flat Rate:

35' @ 50¢

\$17 50

✓

17 50

Labor

Hadley Press, Inc., Lexington

DATE June 12, 1938

TOWN OF LEXINGTON—BOARD OF PUBLIC WORKS
WATER DIVISION
to Washburn Drive

The undersigned applies for a supply of water at No. _____ St. and hereby agrees to comply with the rules and regulations as now, or at any future time, established by the Board of Selectmen.

Am't. of Estimate \$ W^{on} flat rate.


Owner James Heggie

Am't. Paid \$ _____ *no patching*

Address Washburn Drive

Builder Merle Miller

Sketch of Service Here

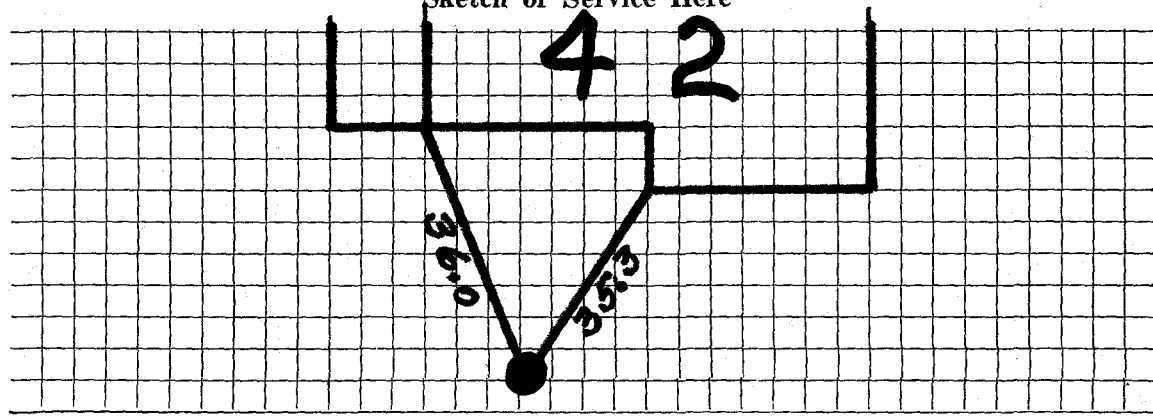

Connection made in _____ Street.

Work completed _____ 19

Remarks: