

WATER SERVICE RECORD

#342

Name Joseph B. Thomas

Service No. 196

Address 45 Wachusett Drive

Location

~~Repair - Renewal - REPAIRS~~

Comm. 11-24-60


Date	Material	Amount	Total	Date	Amount	
9-28-60	Labor	17.28		9-19-60	125.00	
9-29-60	"	15.23	32.51	11-24-60	45.00	
	10% O.H.	3.25	35.76		76.97	
37'	3/4" Copper tubing @.42		15.54		NON CHARGE	
1	3/4" C x 1/2 I.W.H. Stop & Waste		6.17	9-29-60	Labor	5.76
3	hrs. Pippin Shovel @4.50		13.50	12'	3/4" Copper tubing @.42	5.04
2	hrs. Trucking @3.00		6.00	1	3/4" C Curb Cock	6.28
			76.97	1	3/4" Adapter	2.21
				1	hr. Trucking @3.00	3.00
				4 x 3	Patch	4.00
						26.29

DATE _____

TOWN OF LEXINGTON — BOARD OF PUBLIC WORKS

WATER DIVISION

Sketch of Service Here

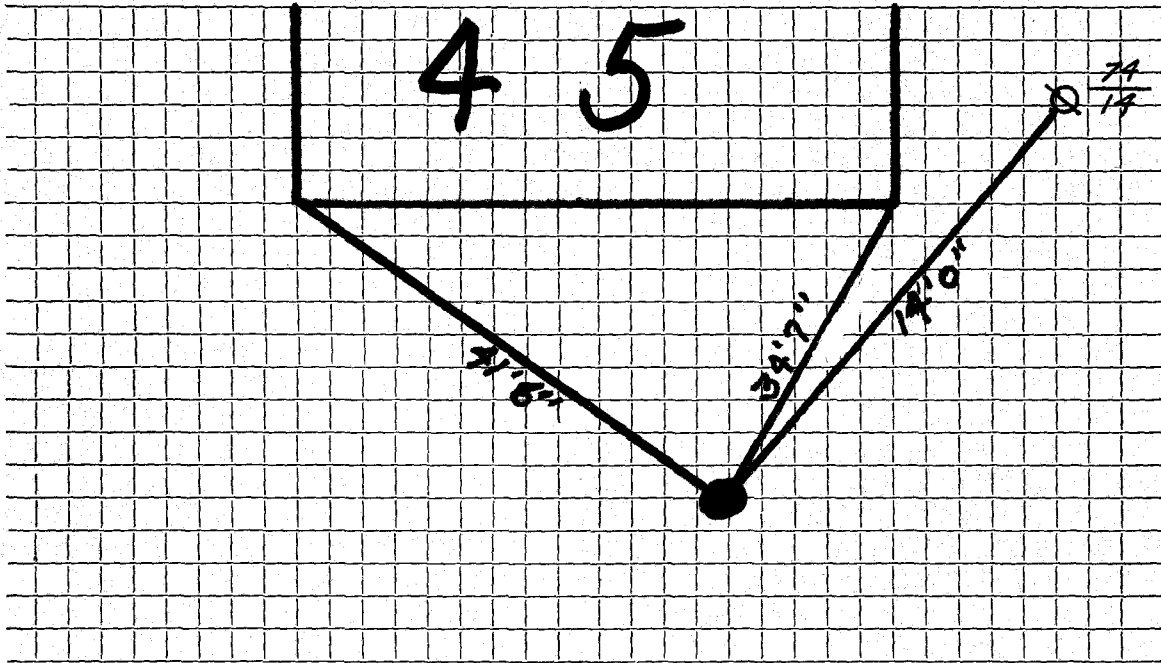

Connection made in Street. Work completed

Remarks: *Original Service 11-22-'26'*

.....
.....