

WATER SERVICE RECORD

#5121
#5122

Name Alden Jefts

Service No. 291

Address 47 Wachusetts Drive

Location

~~RENEWAL SERVICE~~


COPIED 12-31-59

Date	Material	Amount	Total	Date		Amount
11-4-59	Labor	2.10		11-4-59	Deposit	50.00
	10% O.H.	.21	2.31	11-21-59	Retained	5.55
72'	3/4" Copper tubing @.42		30.24			41.45
1	3/4" C x 1/2 I.W.H. Stop & Waste		5.88		NON CHARGE	
1	3/4" C 3 part union		2.27		Labor	1.69
1	hr. Trucking @.75		.75	12'	3/4" Copper tubing@.42	5.04
			41.45	1	3/4" C Corp Cock	4.67
				1	3/4" C Curb Cock	5.98
				1	Box & Rod	5.00
				1	1/2 Straight tailpiece	.50
				1	1/2 Offset tailpiece	.50
						23.38

DATE _____

TOWN OF LEXINGTON — BOARD OF PUBLIC WORKS
WATER DIVISION

Sketch of Service Here

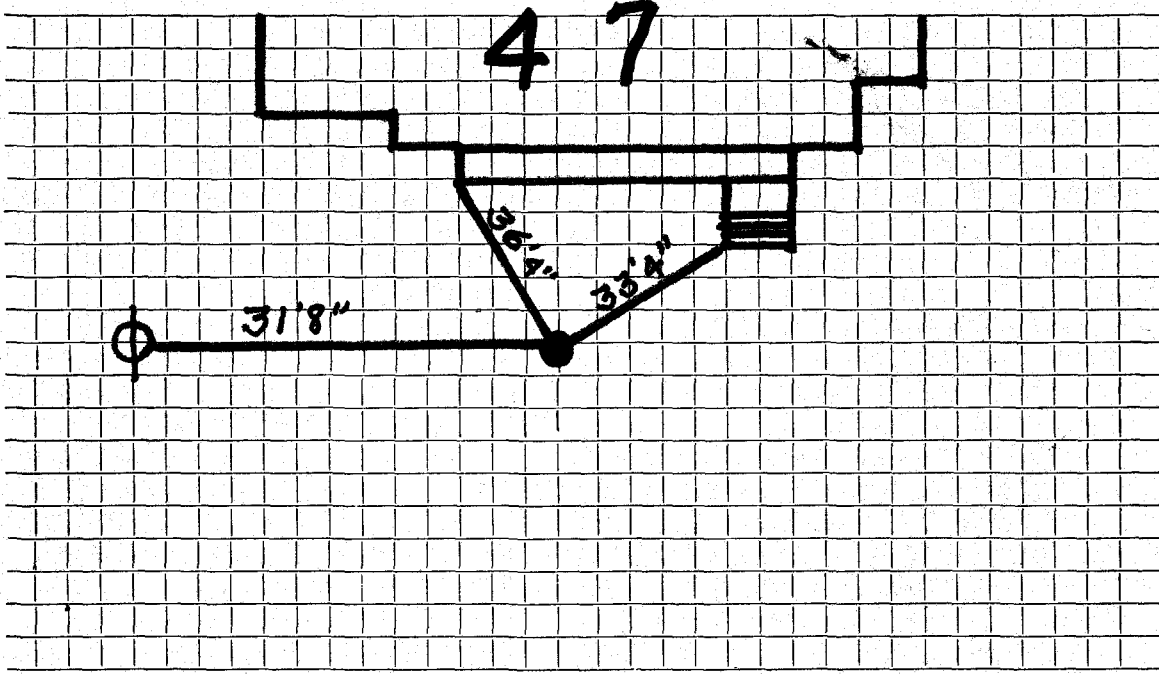

Connection made in Street. Work completed

Remarks: *Original Service 3-30-'27'*

.....
.....