

Name Mrs. Mildred Knisley

Service No. ~~22~~ 2777 # 2380

Address ~~80 Oak Street, Lexington.~~

51 Wachusett Drive

\* 51 Wachusett Drive

# 7731

Location Lot #129 Wachusett Drive

Kind of Pipe

Size

Size of Main

Repair—Renewal—New Service

Location

Date  
1937

Material

Amount

Total

Date

Amount

6/21/37

2 hrs. @ 60¢

1 20

1 20

June 3 1937

Deposited

21 00

42' 34" Cop. Tubing @ 25¢

10 50

1 3/4" S. & W.

3 75

2 hrs. trucking @ 75¢

1 50

16 95

Flat Rate:

42' @ 50¢

\$ 21 00

No patching.

Labor

# TOWN OF LEXINGTON—BOARD OF PUBLIC WORKS

## WATER DIVISION

The undersigned applies for a supply of water at No. Lot #129 Massachusetts Drive St. and hereby agrees to comply with the rules and regulations as now, or at any future time, established by the Board of Selectmen.

Am't. of Estimate \$ \_\_\_\_\_

Owner

Mrs Mildred Knisley

Am't. Paid \$ \_\_\_\_\_


Address

80 Oak St

Builder \_\_\_\_\_

Lexington, Mass

Sketch of Service Here

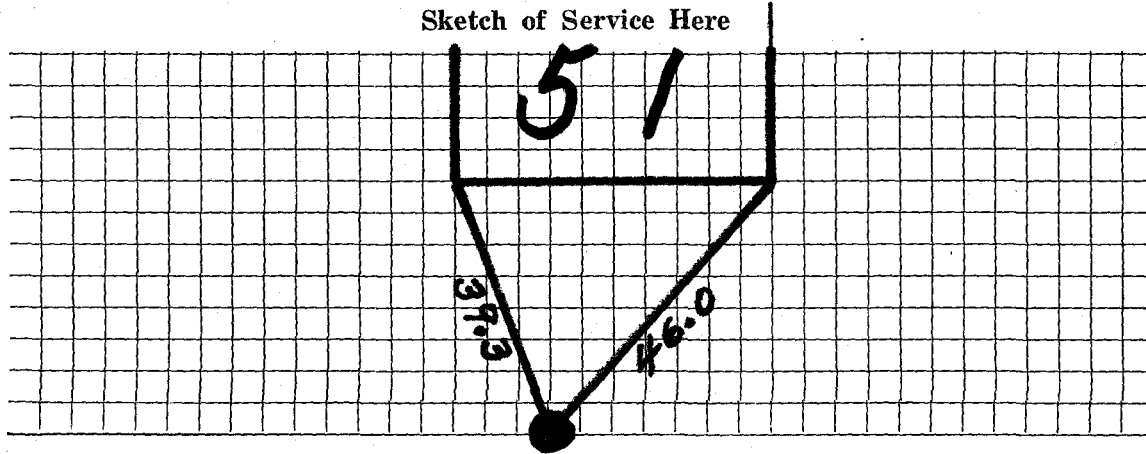

Connection made in \_\_\_\_\_ Street.

Work completed \_\_\_\_\_ 19

Remarks: