

WATER SERVICE RECORD

Name William Catley

Service No. 355

Address 7 Wachusett Drive

Location

~~Repair~~ ~~XXXXXX~~ - New Service

Com. 11-23-53


| Date | Material | Amount | Total | Date | Amount |
|---------|----------------------------------|--------|--------|----------------------------|--------------------------|
| 11/6/53 | Labor | 16 67 | | 11-2-53 | Deposited 125 00 |
| | 10% overhead | 1 67 | 18 34 | 11-23-53 | Refunded (17 39 |
| | 150' - 1" copper tubing@.48 | | 72 00 | | <u>NON CHARGE</u> 107 61 |
| | 1 -1" C x 1" I.W.H. stop & waste | | 4 50 | | SERVICE WAS IN TO CURB: |
| | 2 - 1"C x 1"C. unions @ 2.26 | | 4 52 | 1 -3/4" offset tail pc. | 50 |
| | 1 hr. Littlefield shovel | | 7 50 | 1 - 3/4" straight tail pc. | 50 |
| | 1 hr. trucking | | 75 | | <u>1 00</u> |
| | | | 107 61 | 4/04/96 2' | 1" Copper |
| | TRENCH DUG BY OWNER: | | | 1 | 1" Compression Curb Cock |
| | | | | 1 | 1" Union |

DATE _____

TOWN OF LEXINGTON — BOARD OF PUBLIC WORKS

WATER DIVISION

Sketch of Service Here

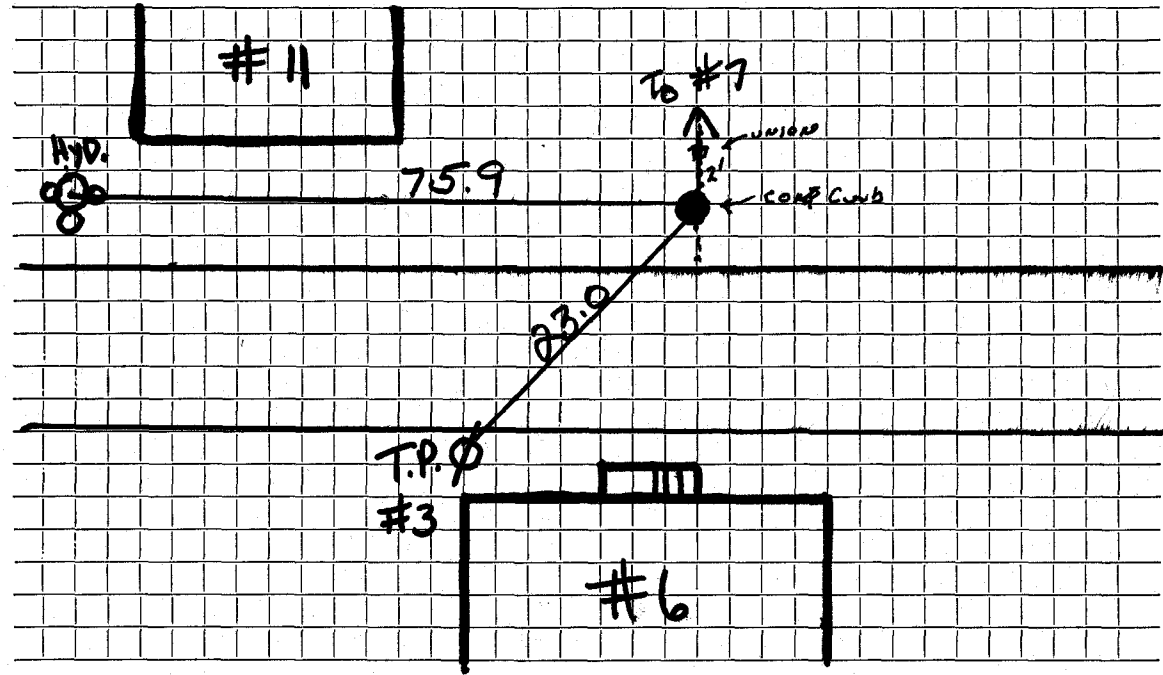

Connection made in Street. Work completed

Remarks:
.....
.....