

**WATER SERVICE RECORD**

Name John Bullock Realty Const.

Service No. 267

Address ~~Wachusett Drive~~ Wachusett Drive

# 1738

Location Lot B

# 1987

Repair—Renewal—New Service

Comm 3-16-59


Date	Material	Amount	Total	Date	Amount
12/12/58	Labor	17 42		11-24-58	<del>15 00</del>
	10% Overhead	1 74	19 16	3-16-59	<del>4 88</del>
	36' - 3/4" Copper tubing @ .37		13 32		31 48
	1 - 3/4" Cx 1/2 I.W.H. Stop & Waste		5 84		43 92
	1 hr. Trucking		75		NON CHARGE
	1 3/4 hrs Town Shovel @ 6.50		4 85	12/2/58	Labor 12 13
			43 92		25' - 3/4" Copper tubing @ .37 9 25
					1 - 3/4" C. Corp Cock 4 64
					1 - 3/4" C. Curb Cock 6 03
					1 Box & Rod 5 00
					1 - 1/2 Straight tailpiece 50
					1 - 1/2 Offset tailpiece 50
					1 1/4 hrs. Town Shovel 4 85
					<u>48 08</u>

DATE \_\_\_\_\_

# TOWN OF LEXINGTON — BOARD OF PUBLIC WORKS

## WATER DIVISION

Sketch of Service Here

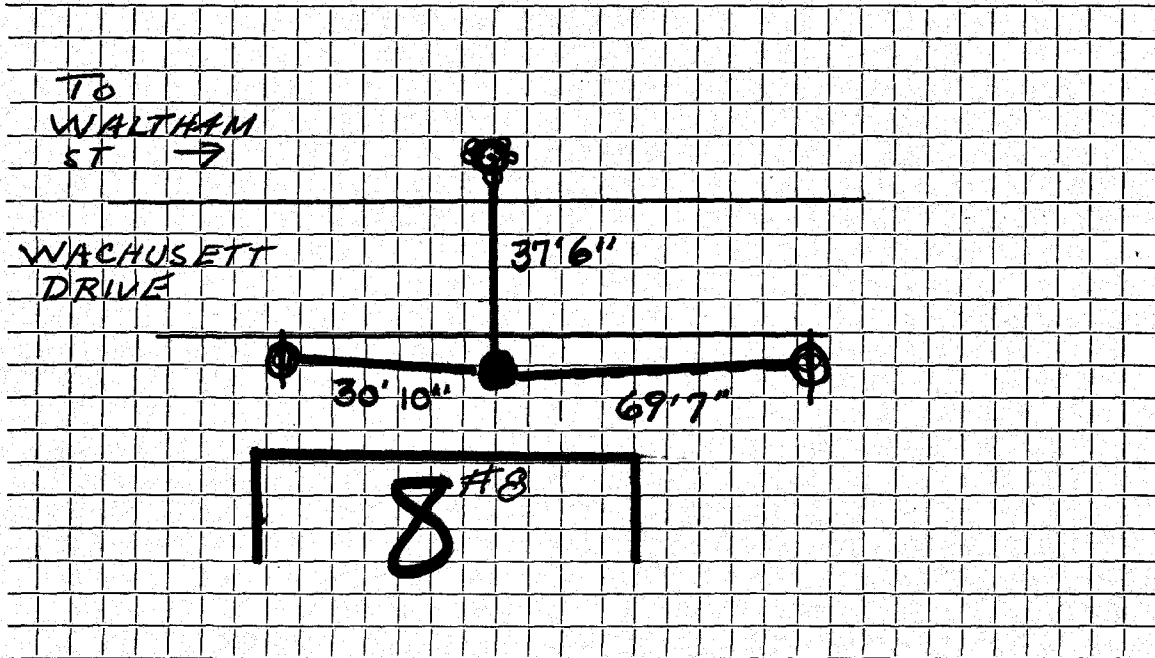

Connection made in ..... Street. Work completed .....

Remarks: .....

.....  
.....