

WATER SERVICE RECORD

Name

Service No.

Address 2 Wachusett Circle

Location


~~RENEWAL~~—Renewal—~~RENEWAL~~

Date	Material	Amount	Total	Date	Amount
11/19/29	34' 1" CLP				
	2 1" L.L. ELLS				
	2 1" BRASS NIPPLES				
					NON CHARGE
				10-8-62	Labor 33.87
					26' 3/4" Copper tubing @.42 10.92
					1 3/4" C Corp Cock 4.91
					21 1/2 ton Bank Gravel @.85 18.06
					2 hrs. Town Shovel @6.50 13.00
					2 hrs. Trucking @3.00 6.00
					2 hrs. Pumping @3.00 6.00
					1 hr. Loader @3.00 3.00
					95.76

DATE _____

TOWN OF LEXINGTON — BOARD OF PUBLIC WORKS
WATER DIVISION

Sketch of Service Here

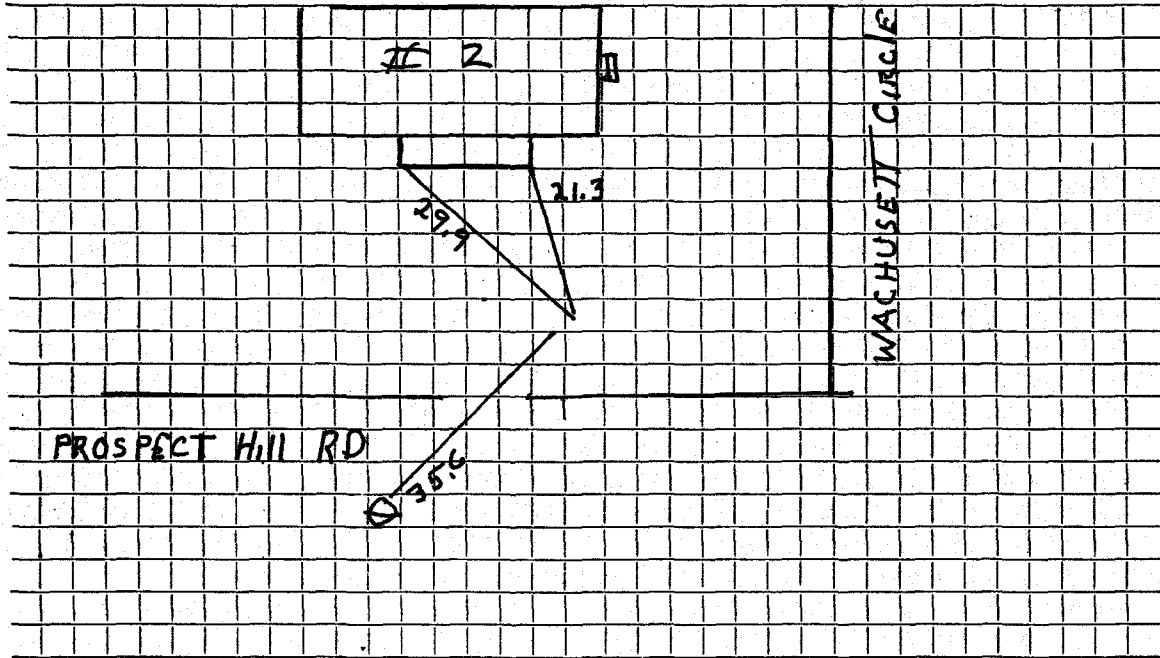

Connection made in Street. Work completed

Remarks:

.....

.....