

WATER SERVICE RECORD

Name **Frederick O. Johnson**

Service No.

Address **3 Wachusetts Circle**

Location


~~Repair~~ ~~Renewal~~ ~~New Service~~

Date	Material	Amount	Total	Date	Amount
5/1/58	Labor	59. 50			
	10% O.H.	5. 95	65. 45		
50'	3/4" Copper tubing @.37		18. 50		
1	3/4" C x 1/2 I.W.H. Stop & Waste		5. 84		
1	hr. Trucking @ Trucking @.75		.75		
1 1/2	hr. Trucking Town Shovel @ 6.50		9. 75		
				10'	3/4" Copper tubing @.37 3.70
				1	3/4" C Corp Cock 4. 64
				1	1 1/2" Lead Lined Elbow 1. 14
				1	1 1/2"x6"C.L.Nipple@.75 . 75
				1	1 1/2"x1" Lead Lined Fed.Coup. 1. 00
			W-0 1803 RENEWAL	1/2	hr. Town Shovel 8. 25
				1/7/87	41' 3/4" Copper 33. 34
				1	1 1/2" Style 38
				1	6" x 1 1/2" C.L. Nipple
				1	1 1/2" x 1" Reducer
				1	3/4" Curb r / Roadway Box
				1	1 1/2" x 3/4" L.F. Adapter
					40 yds gravel 6 yds Cold patch

TOWN OF LEXINGTON — BOARD OF PUBLIC WORKS

WATER DIVISION

Sketch of Service Here

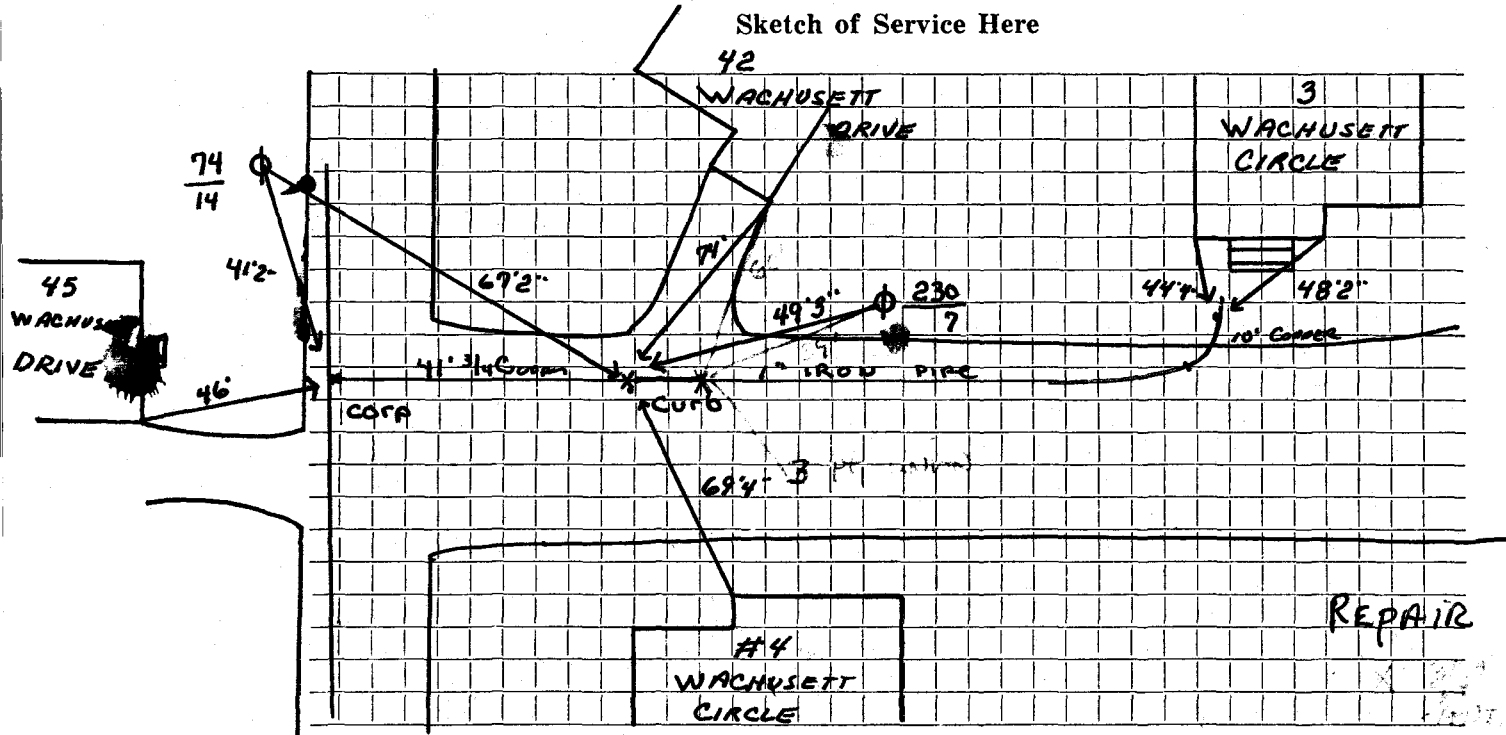

REPAIR MADE 7-5-89

Connection made in Street. Work completed

Remarks:

.....

.....