

WATER SERVICE RECORD

Name Peter Shapiro

Service No.

Address 11 Wachusetts Drive

Location

Repair—Renewal—New Service McKee 4774


Date		Material	Amount	Total	Date	Amount
6/15/89	50'	3/4" Copper				
	1	3/4" Comp Union				
	1	3/4" M x 3/4 Copper Comp.				
					OUTSIDE	
					3/4" Copper	
					3/4 x 3/4 Curb 3/4 Copper X 3/4 Female	
					3/4 Coup	
					Box & Rod	

DATE _____

TOWN OF LEXINGTON — BOARD OF PUBLIC WORKS

WATER DIVISION

Sketch of Service Here

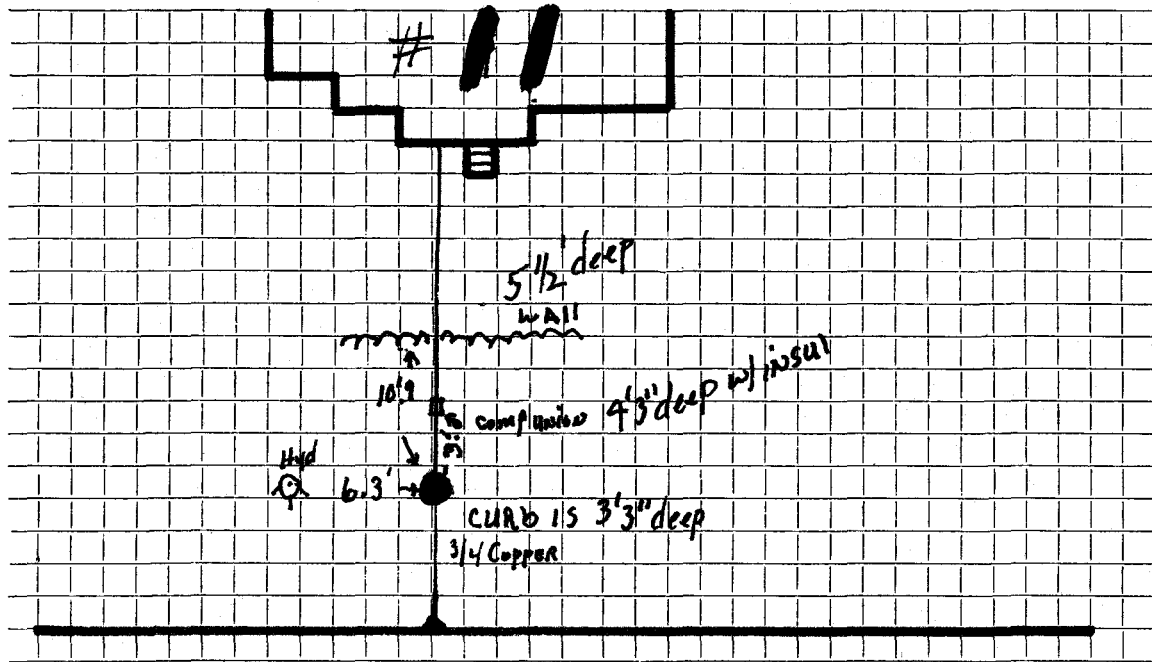

Connection made in Street. Work completed

Remarks:

.....

.....