


DATE _____

TOWN OF LEXINGTON — BOARD OF PUBLIC WORKS

WATER DIVISION

Sketch of Service Here

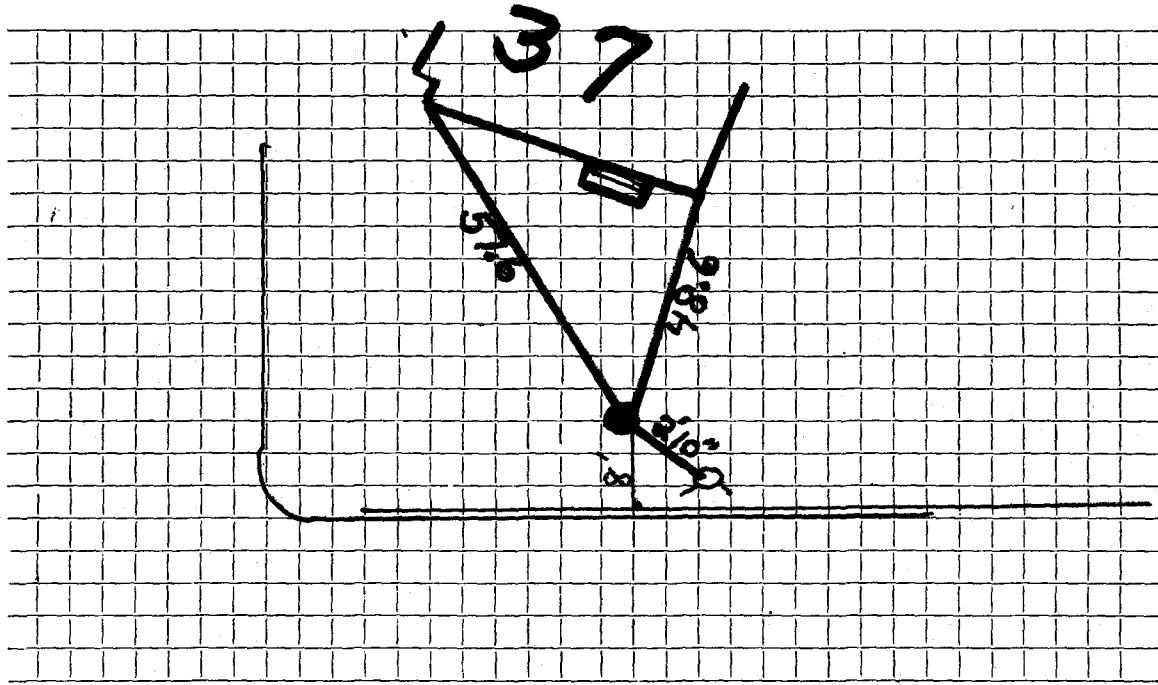

Connection made in Street. Work completed ..11-15-90.....

Remarks: 1" Iron Inside Original Service 6-7-27.....