


DATE _____

TOWN OF LEXINGTON — BOARD OF PUBLIC WORKS

WATER DIVISION

Sketch of Service Ware

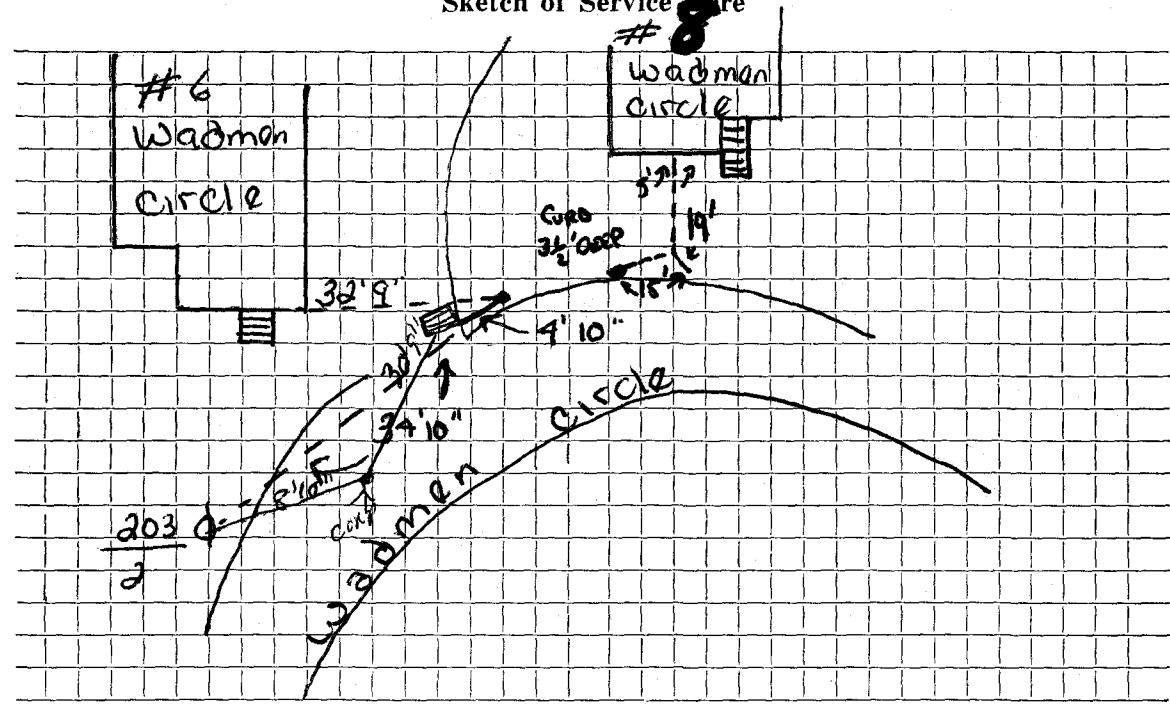

Connection made in Street. Work completed

Remarks:
.....
.....