

WATER SERVICE RECORD

Name W.H. Burgess

Service No. 79

Address 2 Willis Court

Location Lexington


~~Renewal - NEWS COCK~~ COM. 6-8-53

| Date | Material | Amount | Total | Date | Amount |
|--------|------------------------------------|--------|-------|------------------------------|--------------|
| 5/8/53 | Labor | 11 61 | | 4-23-53 Deposited | 25 00 |
| | 10% overhead | 1 16 | 12 77 | 6-8-53 Refunded | 1 36 |
| | 18'-3/4" Copper Tubing @.34 | | 6 12 | NON-CHARGE | 23 64 |
| | 1-3/4" C x 1/2 I.W.H. stop & waste | | 4 00 | 5/8/53 Labor | 42 00 |
| | 1 Hr. Trucking | | 75 | 12'-3/4" Copper Tubing @.34 | 4 08 |
| | | | 23 64 | 1-3/4" C. Adapter | 1 95 |
| | | | | 1-3/4" C x 3/4" C. Curb-cock | 4 67 |
| | | | | 1-Box & Rod | 3 90 |
| | | | | 1-1/2 offset tail piece | 50 |
| | | | | 1 Hr. Trucking | 75 |
| | | | | | <u>57 85</u> |

DATE _____

TOWN OF LEXINGTON — BOARD OF PUBLIC WORKS

WATER DIVISION

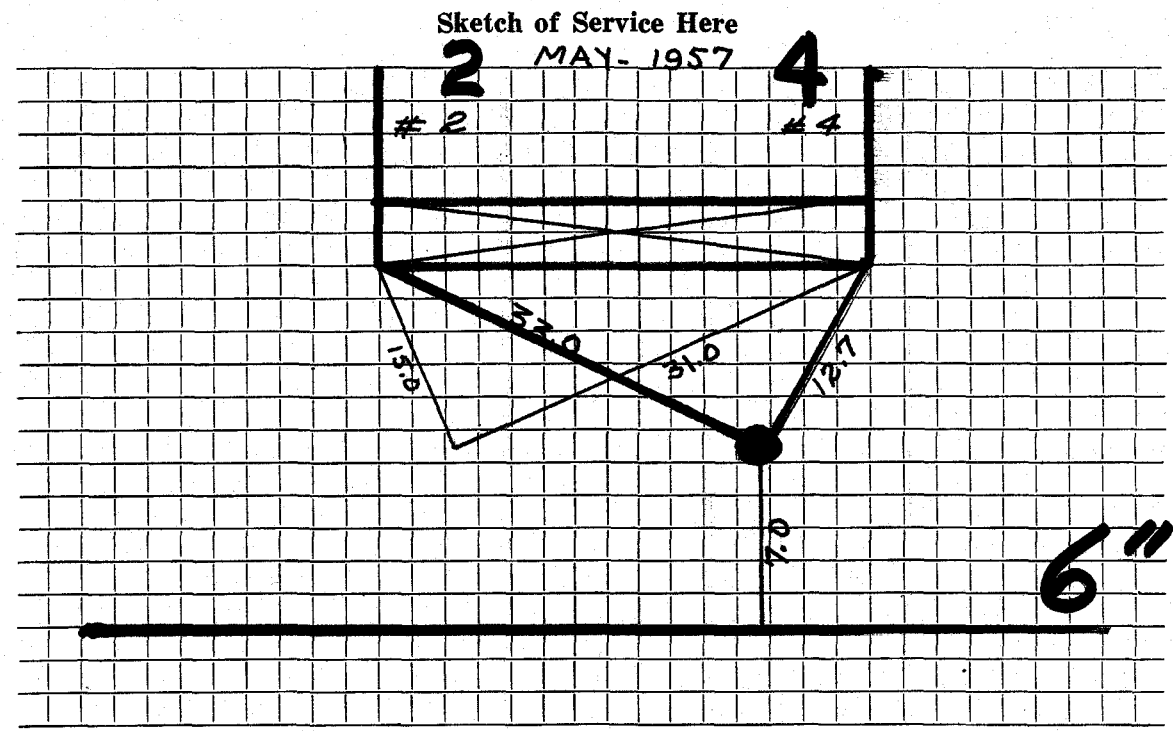

Connection made in Street. Work completed

Remarks: *Original Service 8-23-'26'*

.....
.....