

Name Richard Jackson

Service No. 253

Address 5 Wallis Court

Lexington, Mass.

Locatio 5 Wallis Court

Kind of Pipe

Size

Size of Main

~~Repair—Renewal—New Service~~

Com. 116-50

Location

Date	Material	Amount	Total	Date	Amount
Sept. 1, '50	Labor	1 30	1 30	Aug 18 '50	10 00
	10% Overhead		13	Nov. 13 '50	97
	20' - 3/4" Copper Tubing @.275		5 50		10 97
	1 - 3/4" C x 1/2" I.W.H. S&W		3 29	Aug. 3, '50 Labor	22 56
	Trucking 1 hr. @.75		75	Sept. 1, '50 Labor	1 25
			10 97	7' 3/4" Copper Tubing @.275	1 93
				1 - 3/4" C Adapter	1 57
				1 - 3/4" C x 3/4" Curb-cock	3 85
				1 - 1/2" Offset Tail Piece	42
				Littlefield Shovel 1 hr. @7.00	7 00
				Trucking 1 hr. @.75	75
					39 33
	Labor				

Bill sent 11-2-50

Deposited
Paid

No Charge

DATE _____

TOWN OF LEXINGTON—BOARD OF PUBLIC WORKS

WATER DIVISION

The undersigned applies for a supply of water at No. _____ St. and hereby agrees to comply with the rules and regulations as now, or at any future time, established by the Board of Selectmen.

Am't. of Estimate \$ _____


Owner _____

Am't. Paid \$ _____

Address _____

Builder _____

Sketch of Service Here
NEW - MAY - 1957

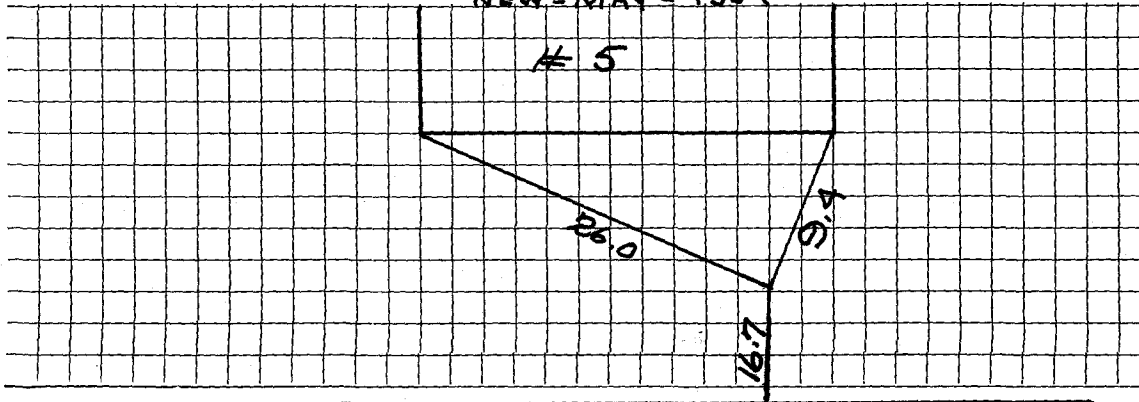

Connection made in _____ Street.

Work completed _____ 19


Remarks:

DATE _____

TOWN OF LEXINGTON — BOARD OF PUBLIC WORKS

WATER DIVISION

Sketch of Service Here

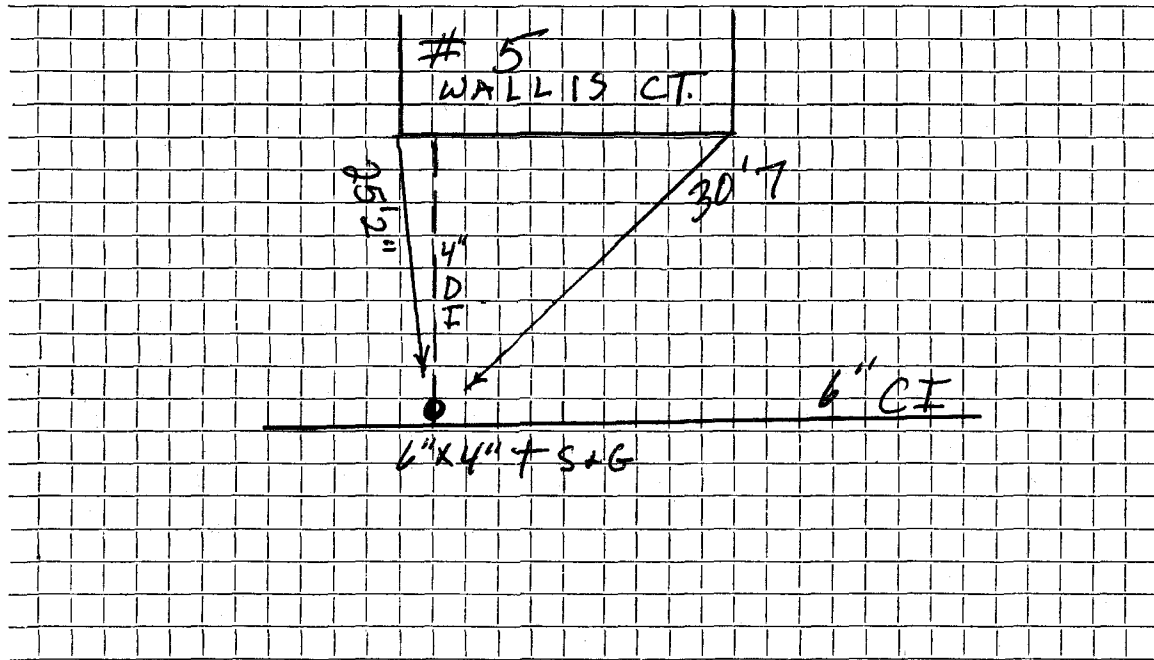

Connection made in Street. Work completed

Remarks:
.....
.....