

WATER SERVICE RECORD

Name **Dennis J. Fullerton**

Service No. **198**

Address **6 & 8 Wallis Court**

Location **Lexington, Mass.**


~~Repair~~—Renewal—~~Max Service~~ **Com. 12-26-50**

Date	Material	Amount	Total	Date	Amount
Aug. 4, '50	Labor	1 30	1 30	Jul 31 '50	10 00
	10% Overhead		13	Jul 9 '51	92
	15' - 1" Copper Tubing @.284	4 26	4 26		10 92
	1 - 1" C x 1" I.W.H. S&W		4 48	Aug. 3, '50	9 67
	Trucking 1 hr. @.75		75	Aug. 4, '50	7 55
			10 92	13' - 1" Copper Tubing @.284	3 69
	<i>Bill sent 1-12-51</i>			1" - 1" C Corp-cock	4 62
				1 - 1" C x 1" C Curb-cock	5 60
				1 - Box & Rod	3 35
				1 - 1/2" Offset Tail Piece	42
				1 - 1/2" Straight Tail Piece	42
				Trucking 1 hr. @.75	75
					36 07

DATE _____

TOWN OF LEXINGTON — BOARD OF PUBLIC WORKS
WATER DIVISION

Sketch of Service Here

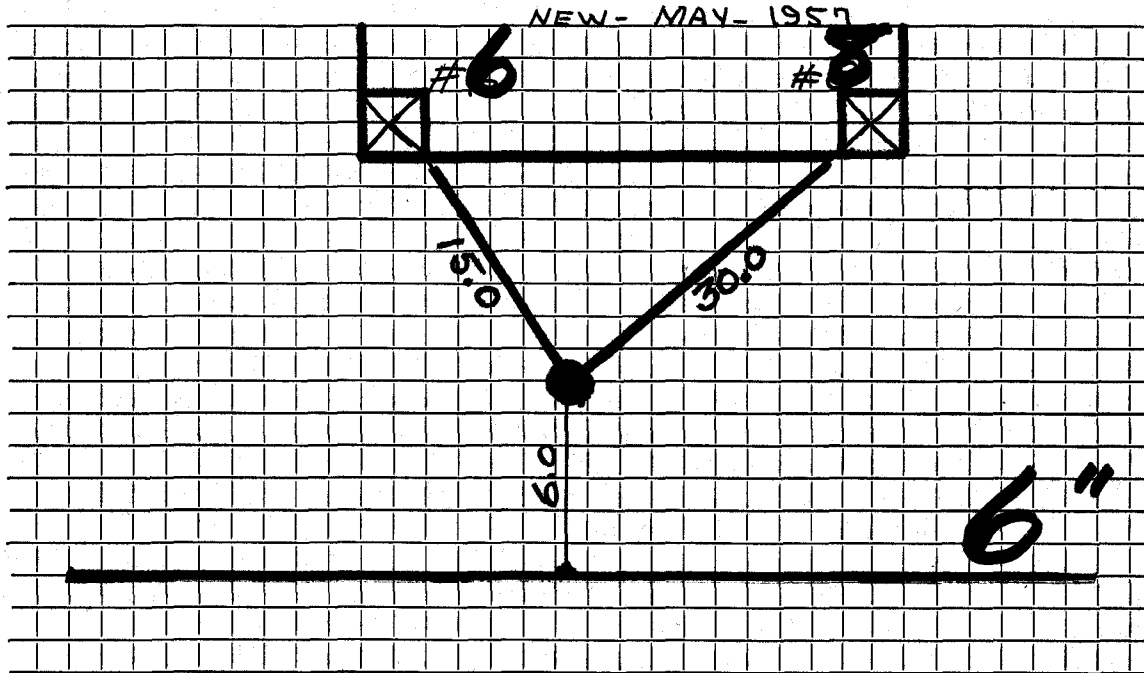

Connection made in Street. Work completed

Remarks:

.....
.....