

WATER SERVICE RECORD

Name

Service No.

Address 10 WALNUT STREET

Location

Repair—Renewal—New Service RENEWAL


Date	Outside	Material	Amount	Total	Date	Amount
8	94	18.5' OF 1" COPPER 1-1" CURB STOP 1-1" x 3/4" REDUCER				
					6-12-'53	
						Inside
						96' 3/4" Copper
						1 3/4" c. X 1/2" I.W.H. STOP + WASTE
						1 3/4" c. X 3/4" c. 3 PART UNION

DATE 8/94

TOWN OF LEXINGTON — BOARD OF PUBLIC WORKS

WATER DIVISION

Sketch of Service Here

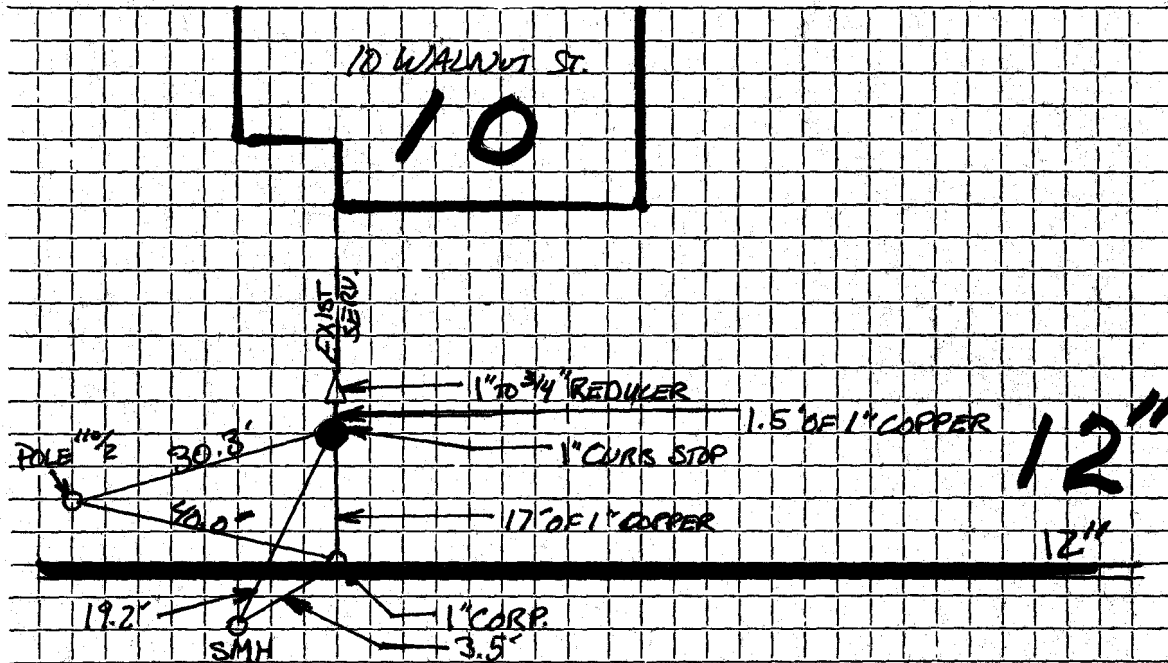

Connection made in Street. Work completed

Remarks:
.....
.....