

WATER SERVICE RECORD

Name

Service No.

Address 11 WALNUT ST

Location

Repair—Renewal—New Service McLaughlin


Date	Material	Amount	Total	Date	PAYOLINI	Amount
10/15/98	85' 1" COPPER 1" Valve			8/94	15.6" 1" COPPER	
					1 1" CORP	
					1 1" CURB STOP	
					1 Baffle Box	

DATE _____

TOWN OF LEXINGTON — BOARD OF PUBLIC WORKS

WATER DIVISION

Sketch of Service Here

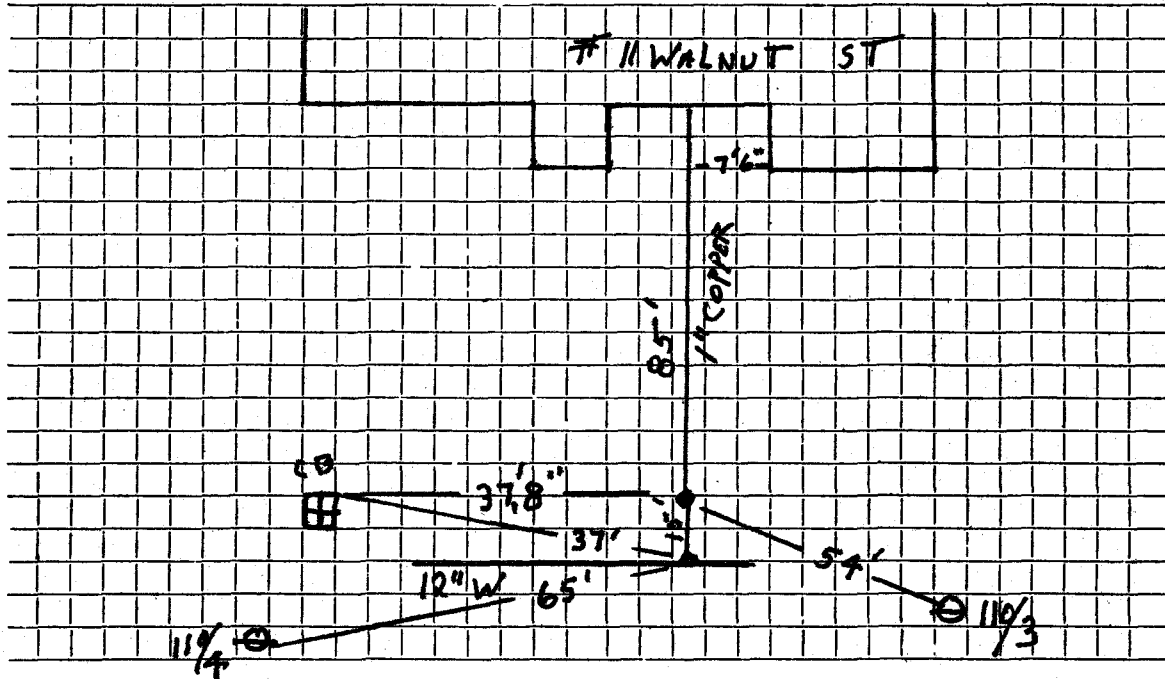

Connection made in Street. Work completed

Remarks:

.....

.....