




DATE MAY 4-01

TOWN OF LEXINGTON — BOARD OF PUBLIC WORKS

**WATER DIVISION**

Sketch of Service Here

14 WALNUT ST

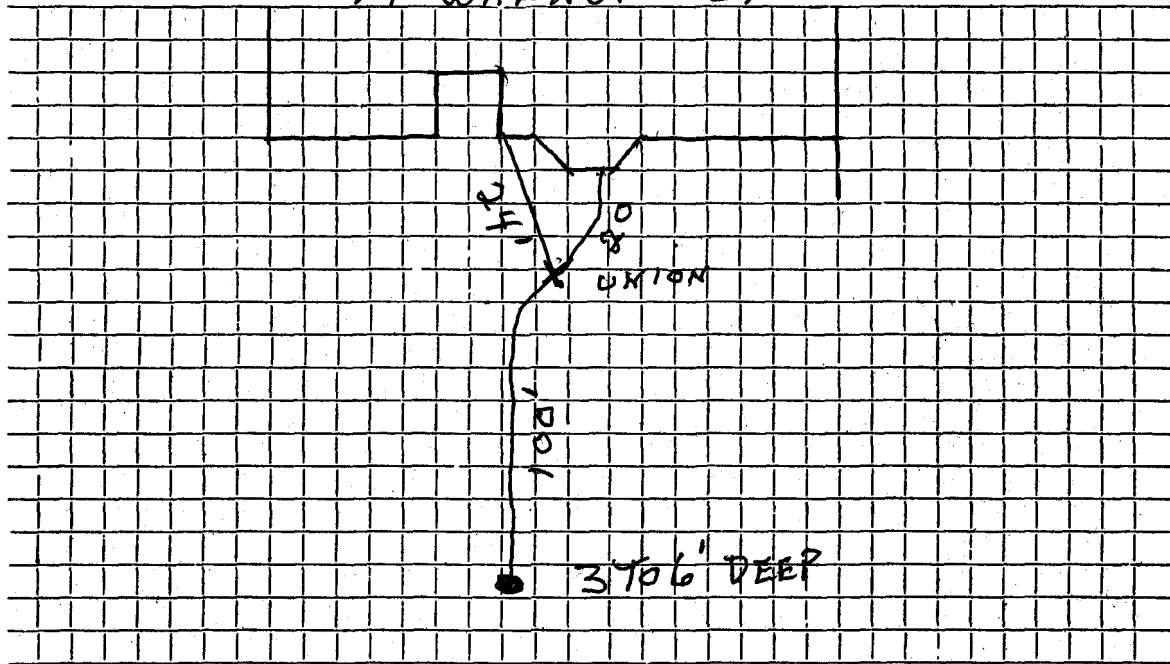

Connection made in WALNUT Street. Work completed MAY 5-01

Remarks: INSTALLED BY JOHN LITCHFIELD JR.