


Water Service Tie Card
TOWN OF LEXINGTON
 MASSACHUSETTS

18 Walnut St

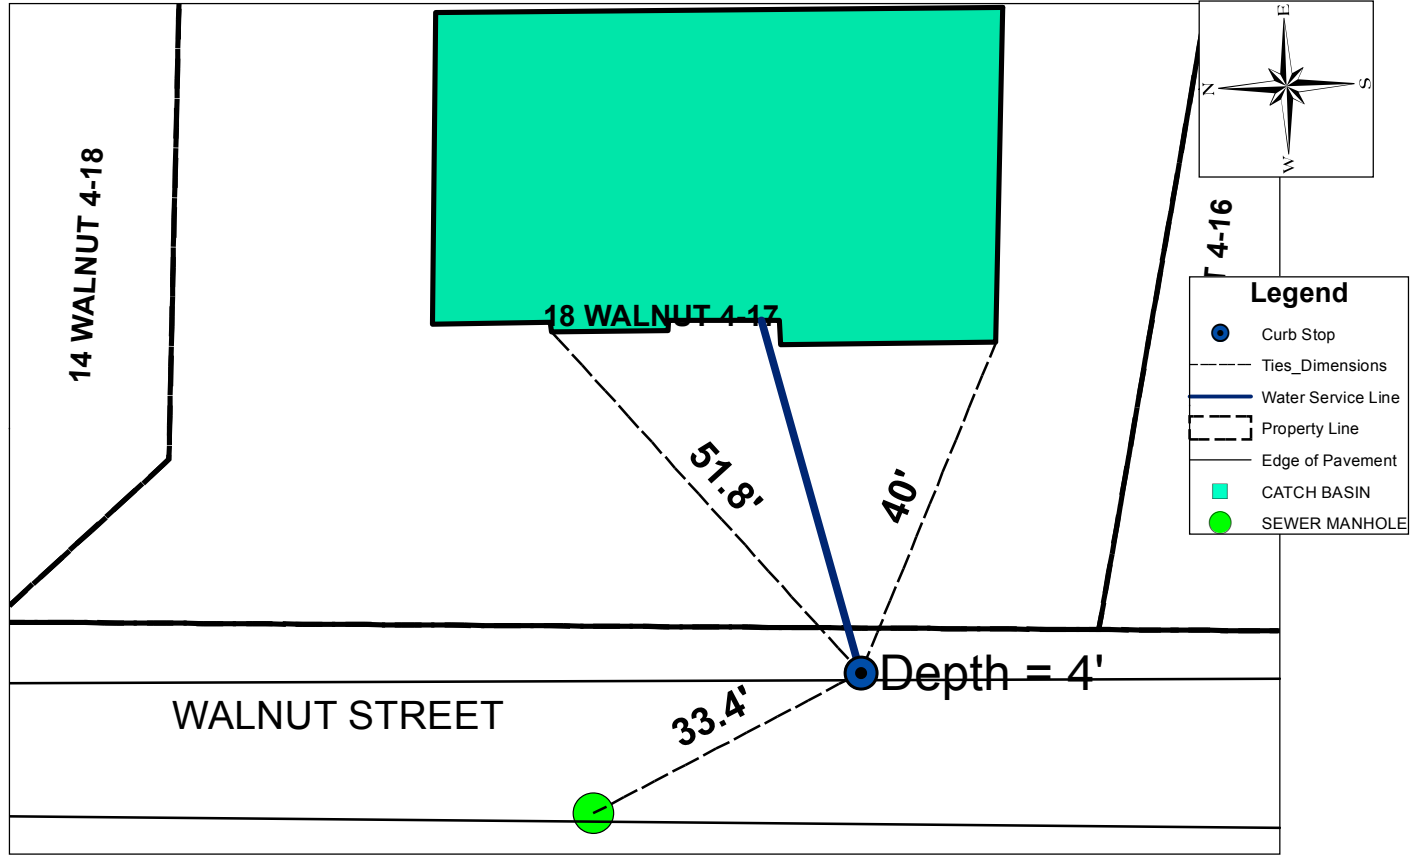

Address	Map and Lot	Permit Number	Contractor Name	Inspector
18 Walnut St	4-17	5887	Caccavaro Const Inc	dpavlik msprague
Date	Material	Depth of Cover	Amount	
9/18/2014	1" Copper type "k" 1" Curb Valve and Buffalo Box	9 ft at HSE 4 ft	60 ft	
Type of work completed				

New 1" water service to house from curb stop. New house on lot old house removed.