




8/5/08

DATE \_\_\_\_\_

TOWN OF LEXINGTON — BOARD OF PUBLIC WORKS

WATER DIVISION

Sketch of Service Here

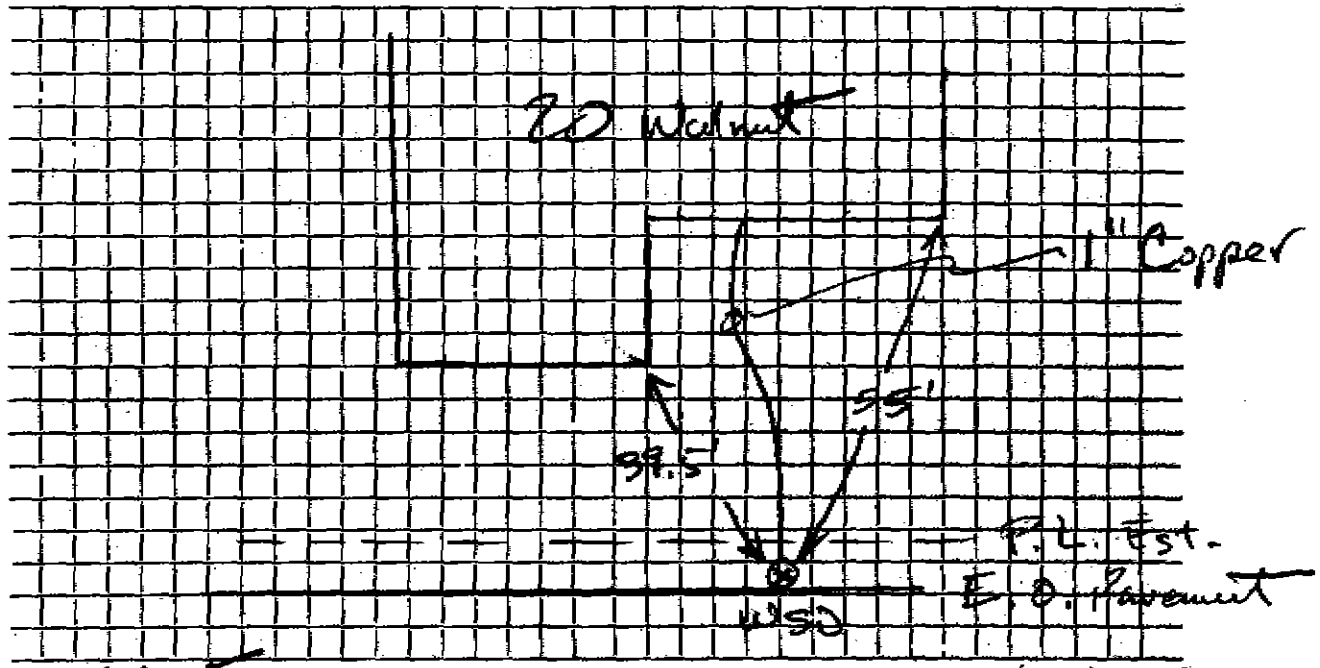

Connection made in Walnut Street. Work completed 8/5/08

Remarks: M. Namang  
Eng. Div.